


T.9S.R.26E.W.M.

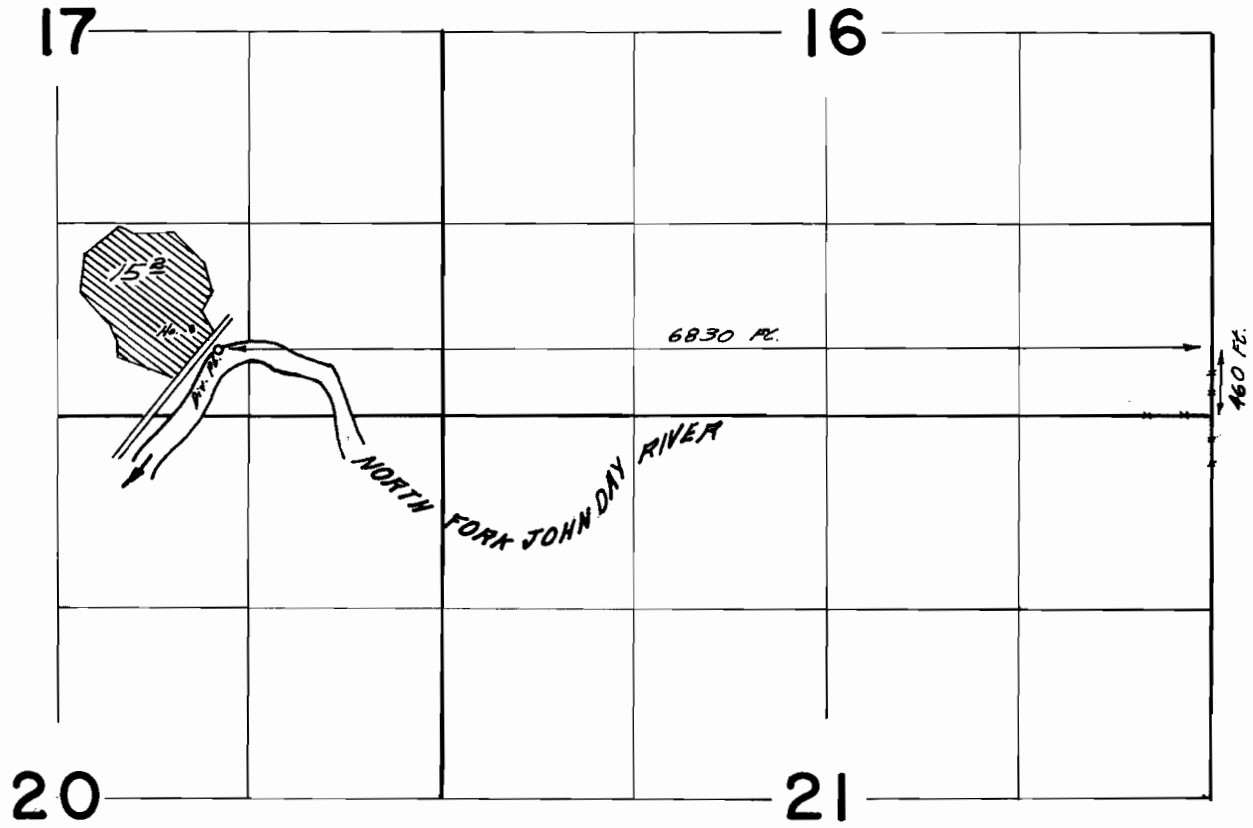

FINAL PROOF SURVEY
UNDER

Application No. 39619 Permit No. 29440
IN NAME OF

EDWARD E. KILBY

Surveyed May 16 1968, by W. J. Ruppert