


T.25 & 26 S. R.34 E. W.M.

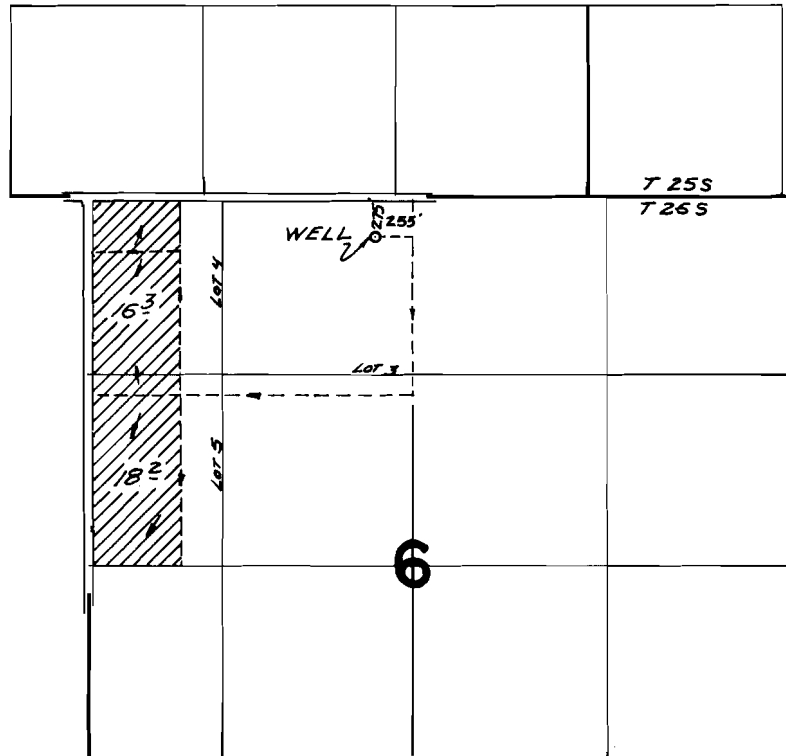

FINAL PROOF SURVEY
UNDER

Application No. G-2950 Permit No. G-2745
IN NAME OF

ALFRED and JOSEPH R. OTLMAN

Surveyed Aug. 8 1968, by V. Garner