


T. 30 S. R. 33 E. W.M.

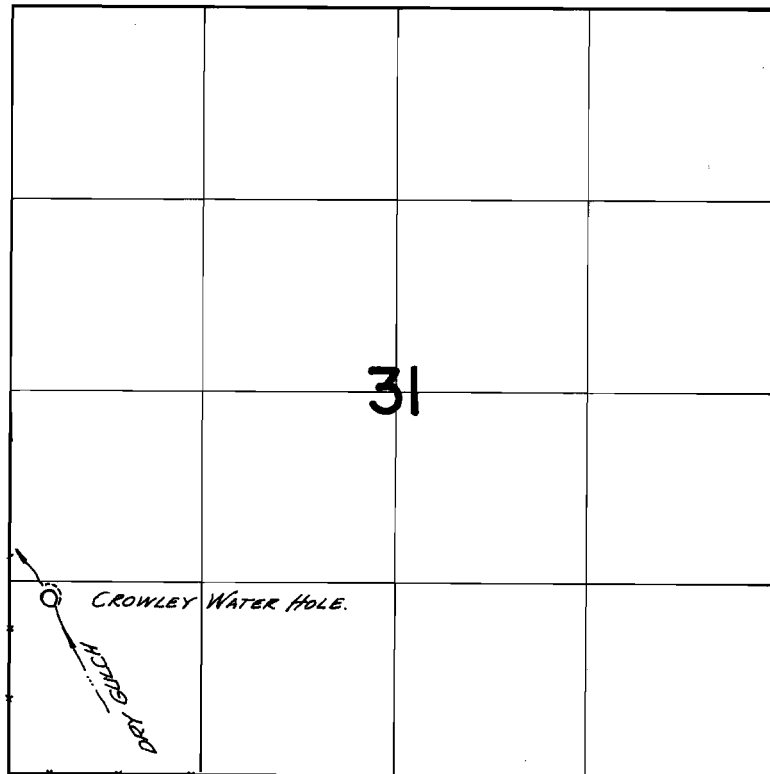

FINAL PROOF SURVEY
UNDER

Application No. R. 43012 Permit No. R. 4897
IN NAME OF

LEON THOMPSON

Surveyed AUG 8, 1968, by V. Garner