


T. 32 S. R. 32 E & 32 1/2 E. W.M.

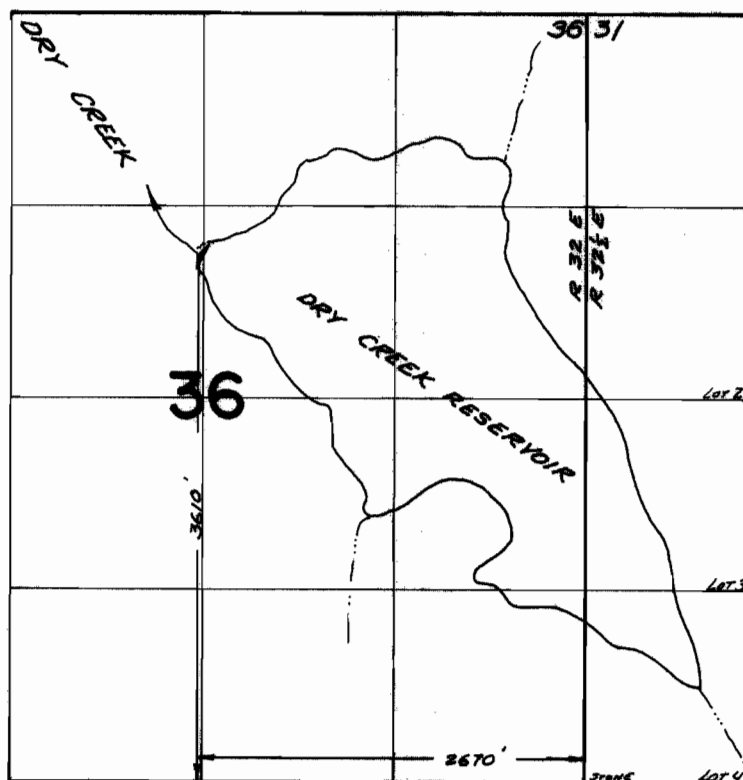

FINAL PROOF SURVEY
UNDER

Application No. R-34506 Permit No. R-2573
IN NAME OF

M. H. KUNDERT

Surveyed Aug. 7, 1968, by V. Garner