


T.32 S. R.32 E.W.M.

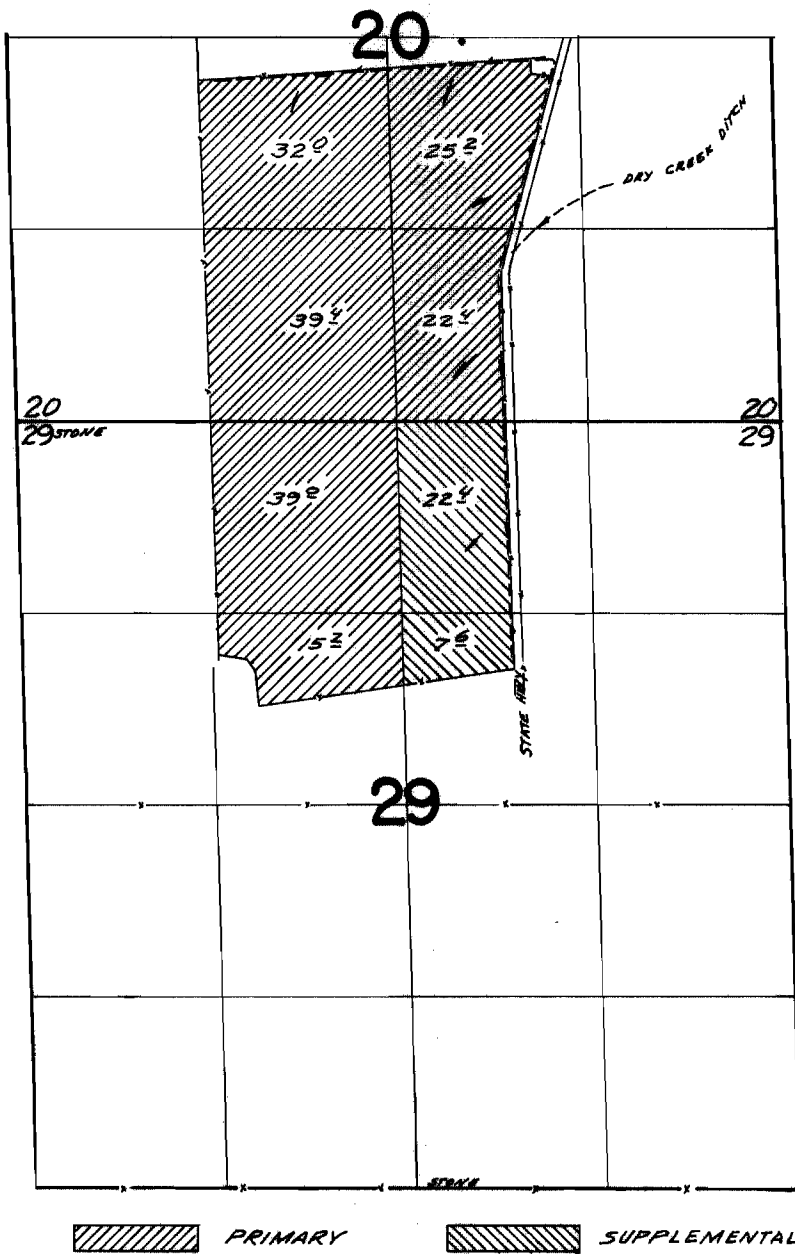

FINAL PROOF SURVEY

UNDER

Application No. 34507 Permit No. 27/04
IN NAME OF

M. H. KUNDERT

Surveyed Aug 7, 1968, by V. Garner