


20285

36765
36764

T. 38 S. R. 3 & 4 E. W. M.

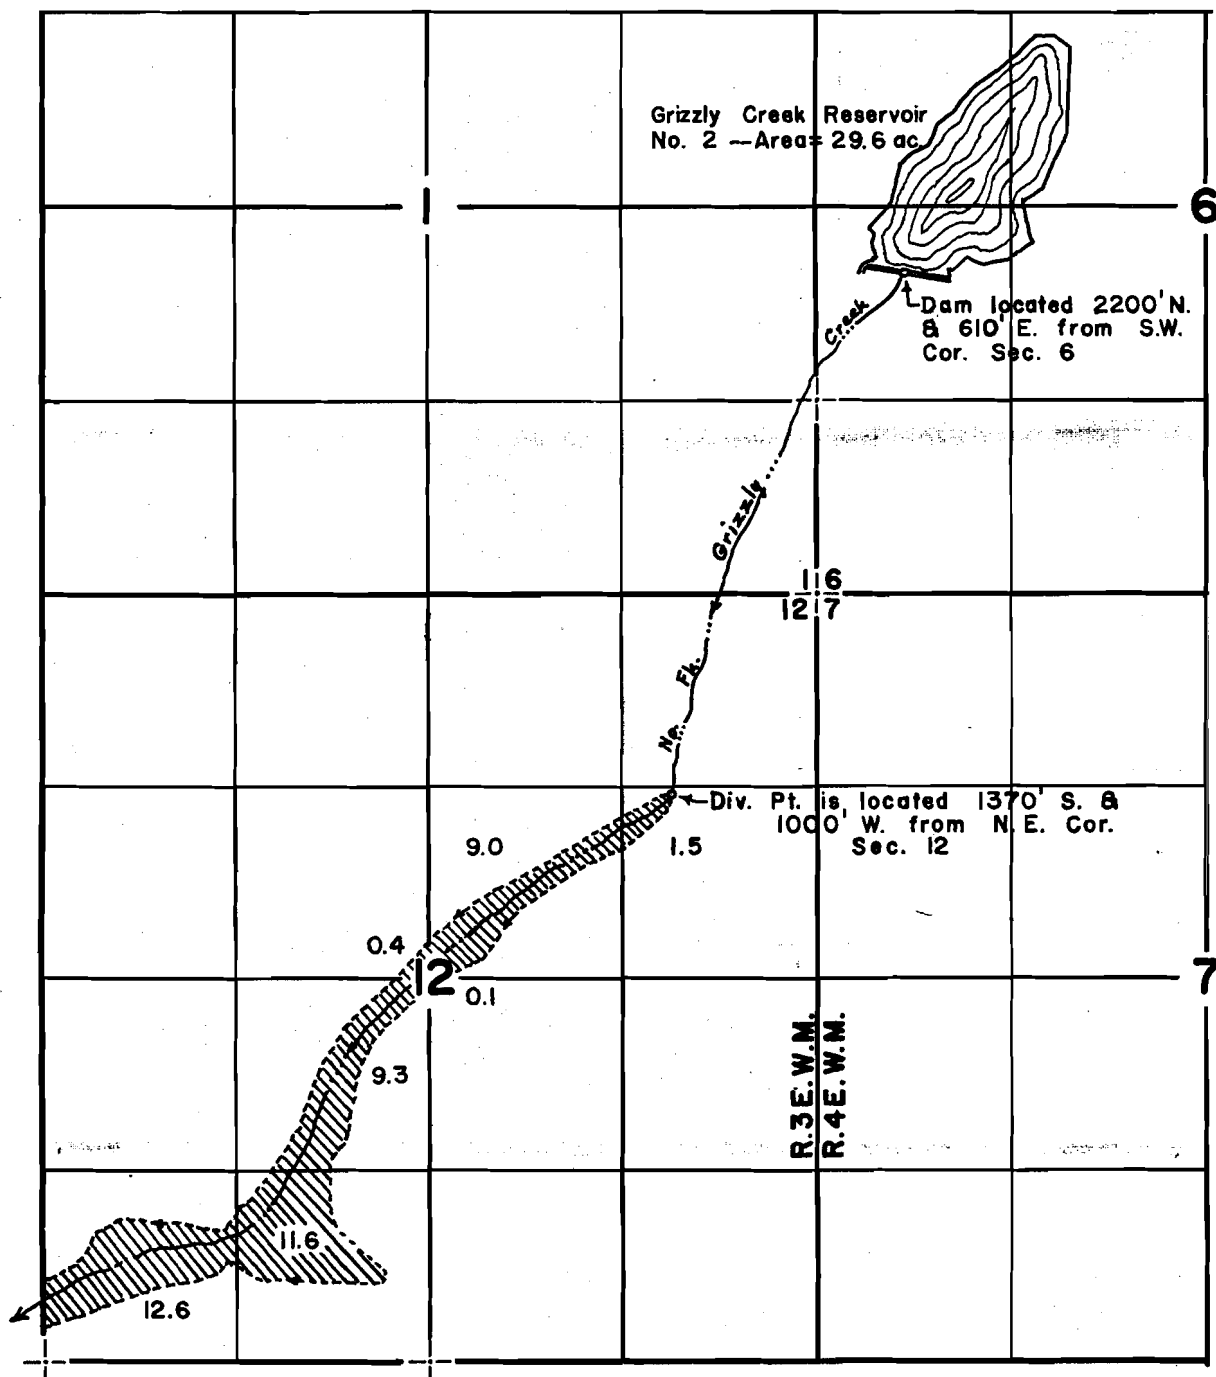

FINAL PROOF SURVEY UNDER

Application No. R-25817 25818 Permit No. R-1163 20285
IN NAME OF

Henry A. Owens

Surveyed May 21, 1963, by C. Baker