


20285  
36765  
36764

# T. 38 S. R. 38 & 4 E. W. M.

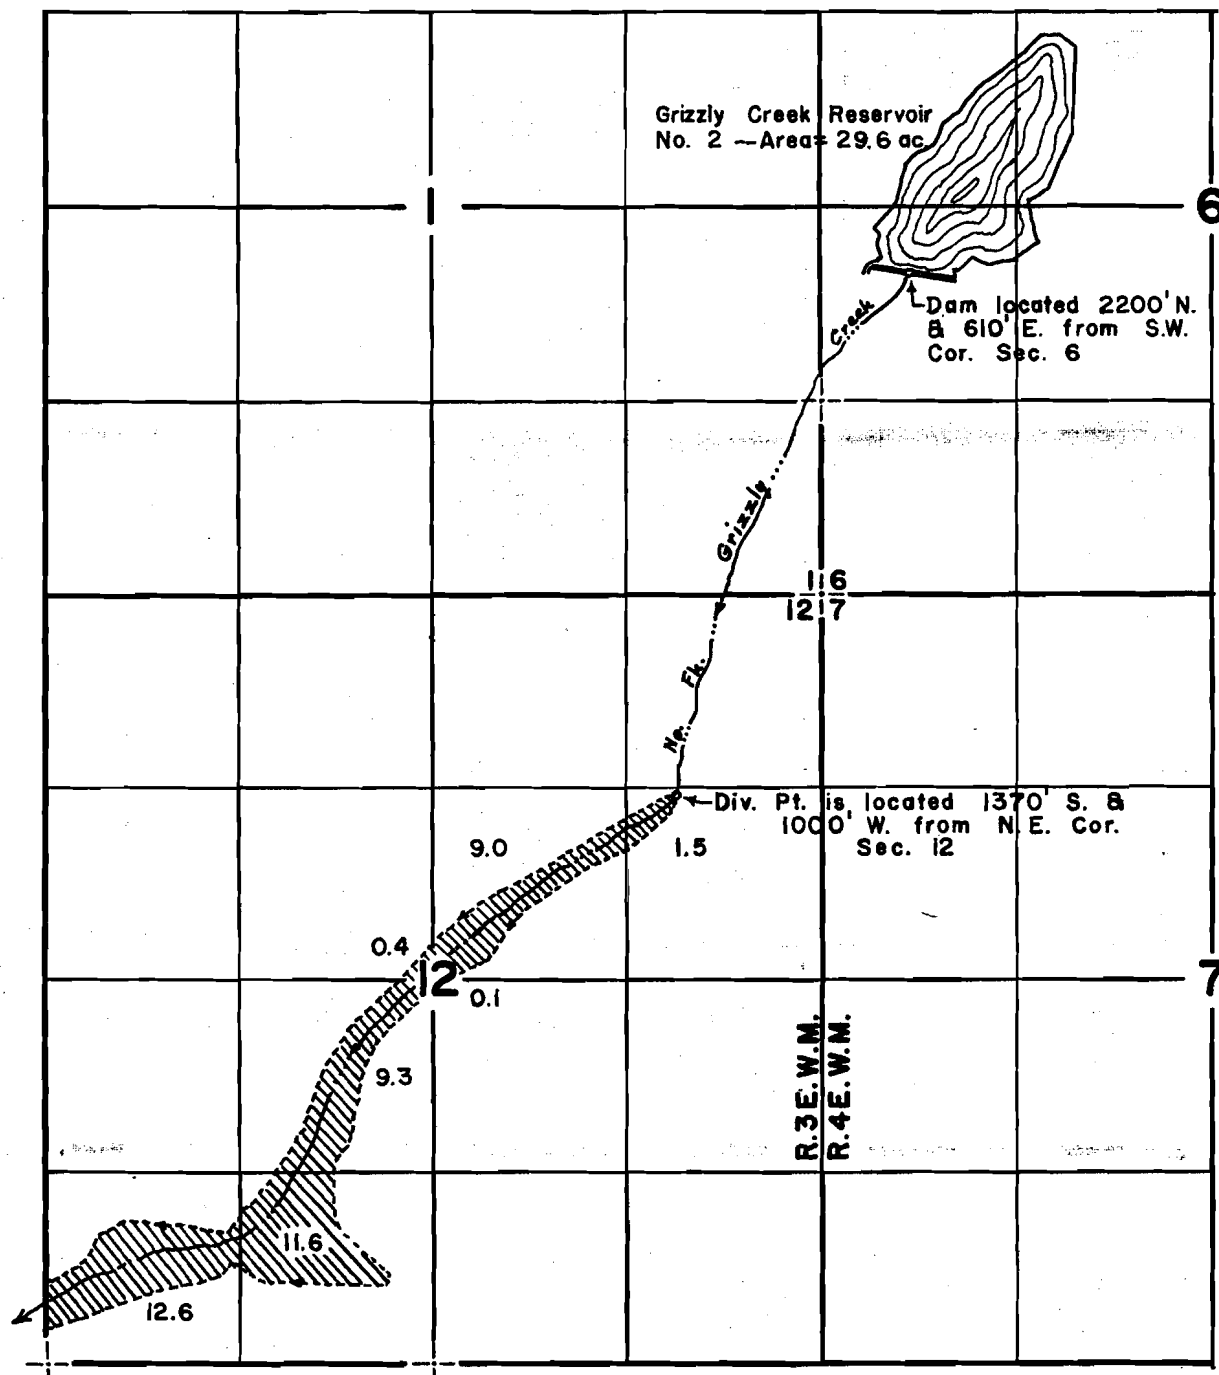

## FINAL PROOF SURVEY UNDER

Application No. R-25817 Permit No. R-1163  
25818 IN NAME OF

Henry A. Owens

Surveyed May 21, 1963, by C. Baker