

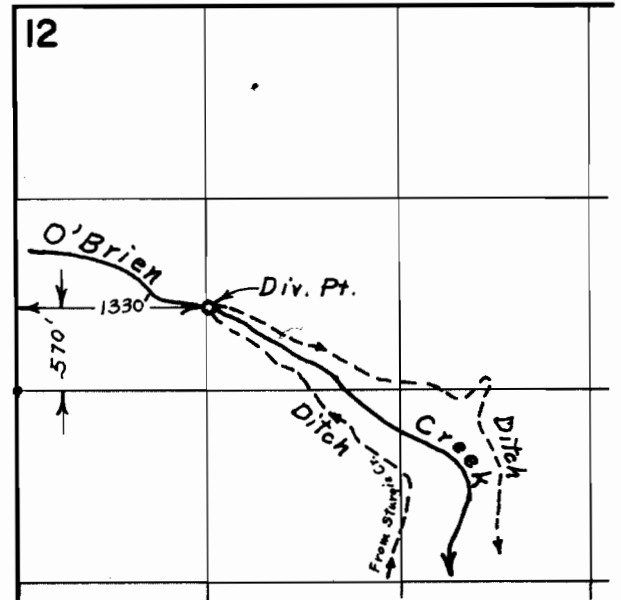


# T.40 S.R.5 W.W.M.

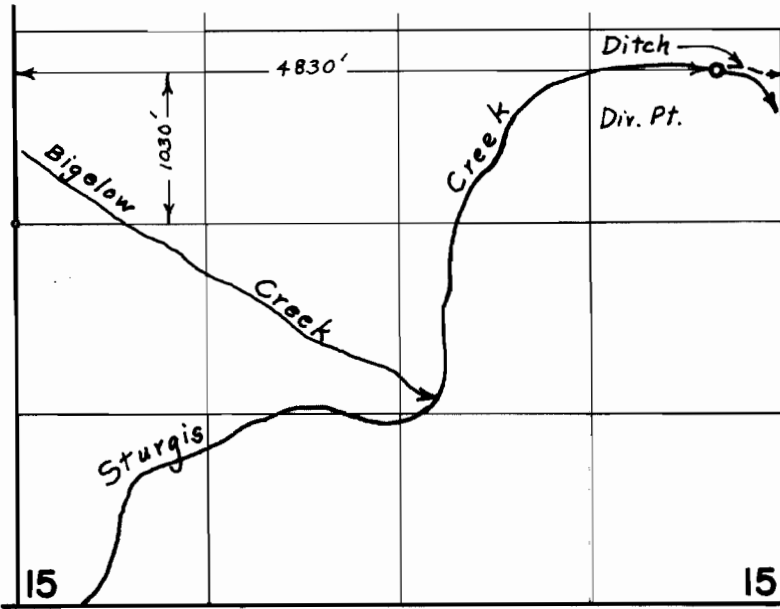

# T.38 S.R.4 W.W.M.

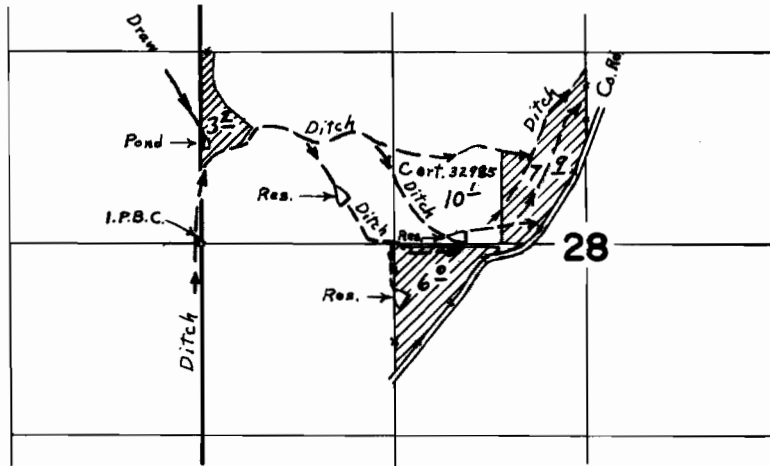

## FINAL PROOF SURVEY UNDER

Application No. 34957 Permit No. 27416  
IN NAME OF  
D. G. MILLER

Surveyed Aug. 1, 1967, by L. E. Gould