


T.39S. R.8W. W. M.

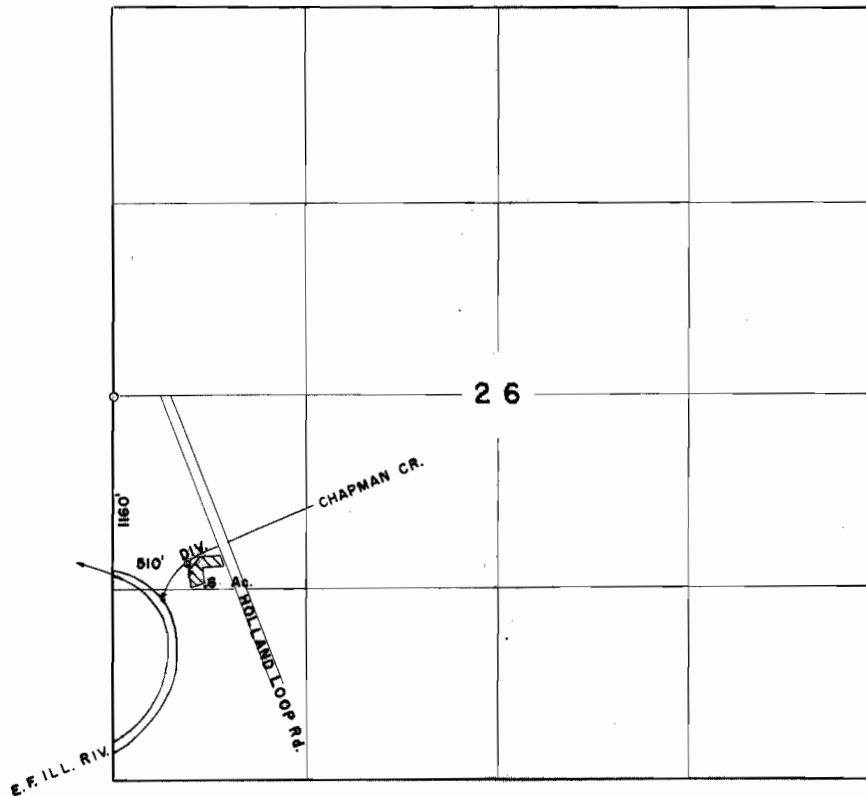

FINAL PROOF SURVEY
UNDER

Application No. 33969..... Permit No. 26817.....
IN NAME OF

AMANDA JACOBSON

Surveyed SEPT. 25, 1968, by R.B. STEJMER.....