


G. 2401
36769

T. 40S. R. 19E. W.M.

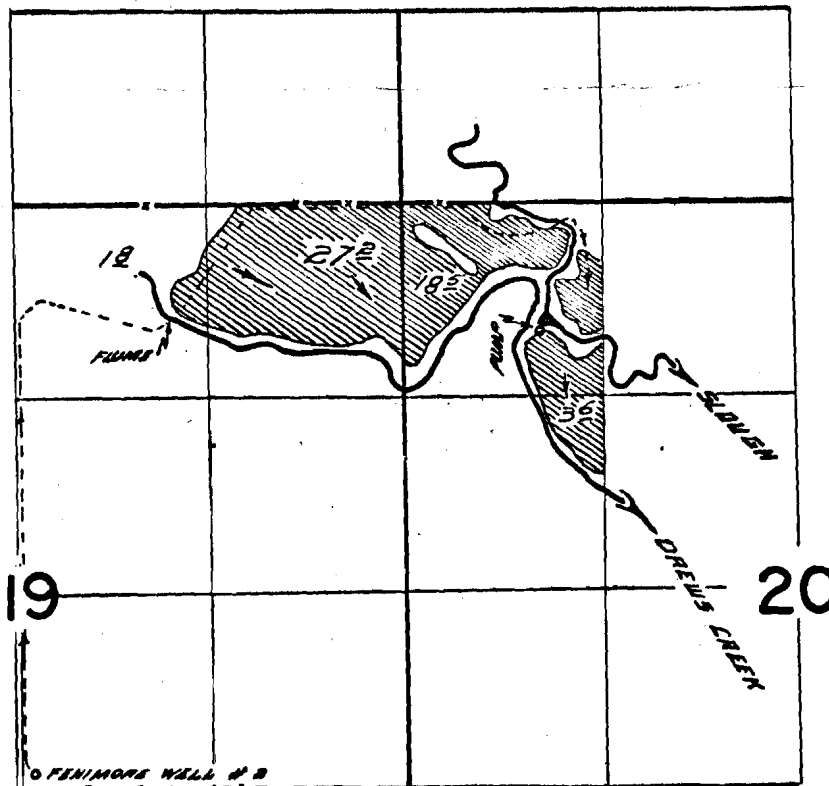

WELL LOCATED 100 FT. N & 105 FT. E FROM SW CORNER NW 1/4 SEC 19

FINAL PROOF SURVEY
UNDER

Application No. *G-2594* Permit No. *G-2401*.
IN NAME OF

CLYDE W. FENIMORE

Surveyed *July 31, 1968*, by *W. V. Ruppert*