


G-2582  
T 7225  
36771

# T.27 S.R.17 E.W.M.

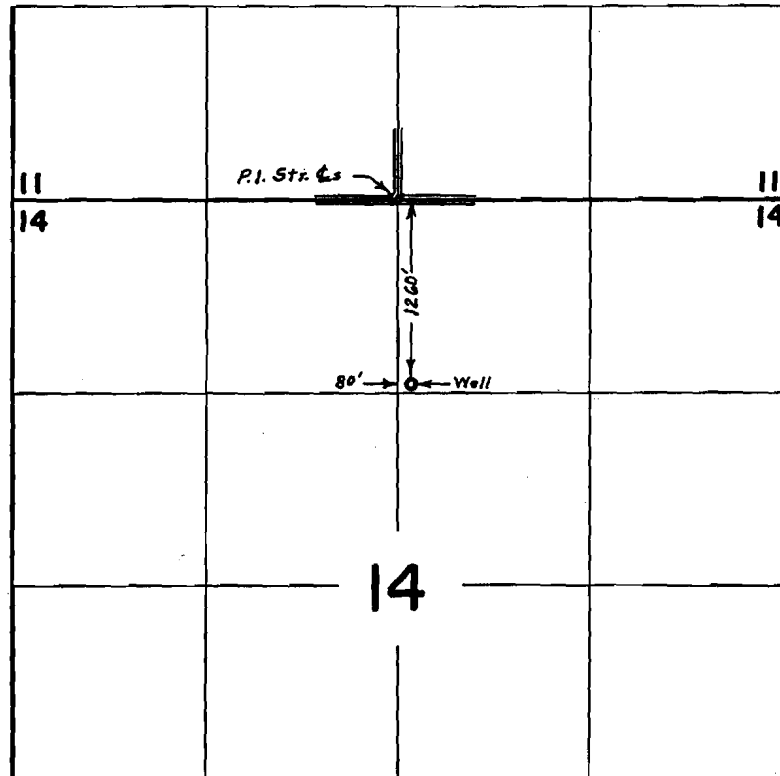

## FINAL PROOF SURVEY UNDER

Application No. G-2679. Permit No. G-2582.  
IN NAME OF  
CHRISTMAS VALLEY MUTUAL  
WATER IMPROVEMENT DISTRICT

Surveyed July 29, 1968, by L. E. Gould.

See T. 7225  
P.O.D. Change