


R 3518
36773

T. 40S. R. 19E. W. M.

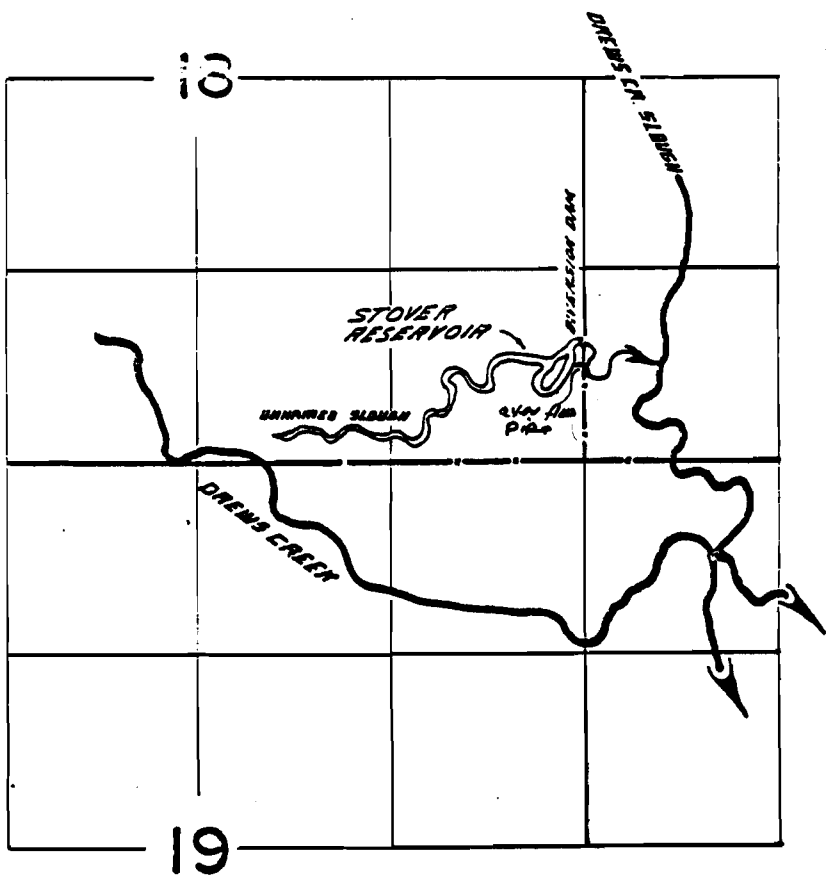

DIVERSION POINT LOCATED 820 FT. N. & 80 FT. W. FROM S.E. CORNER SECTION 18

FINAL PROOF SURVEY
UNDER

A-38443 R-3518
Application No. 38997... Permit No. 29007...
IN NAME OF

HERBERT S. STOVER

Surveyed July 31, 1968, by W. D. Ruppert

20-120