


29007
Q3518 36774

T.40S. R.19E. W.M.

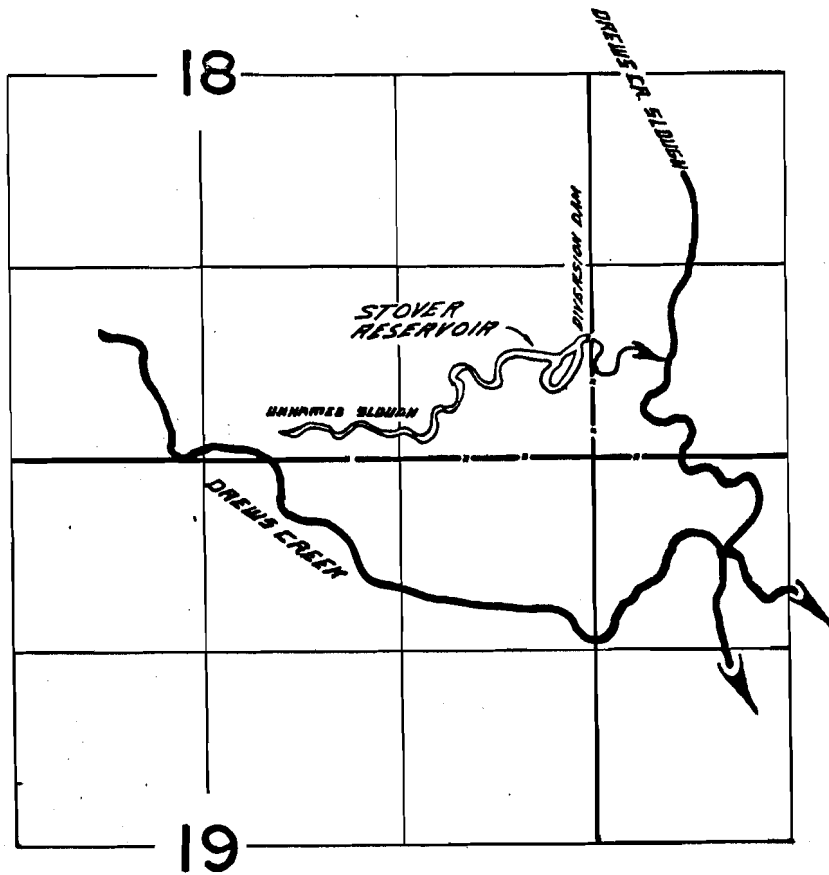

DIVERSION POINT LOCATED 620 FT. N. & 80 FT. W. FROM SE. CORNER SECTION 18

FINAL PROOF SURVEY UNDER

R-38443 R-3518
Application No. 38997... Permit No. 29007...
IN NAME OF

HERBERT S. STOVER

Surveyed July 31, 1968, by W. J. Ruppert

40-19V