


T.II S. R.II W. W.M.

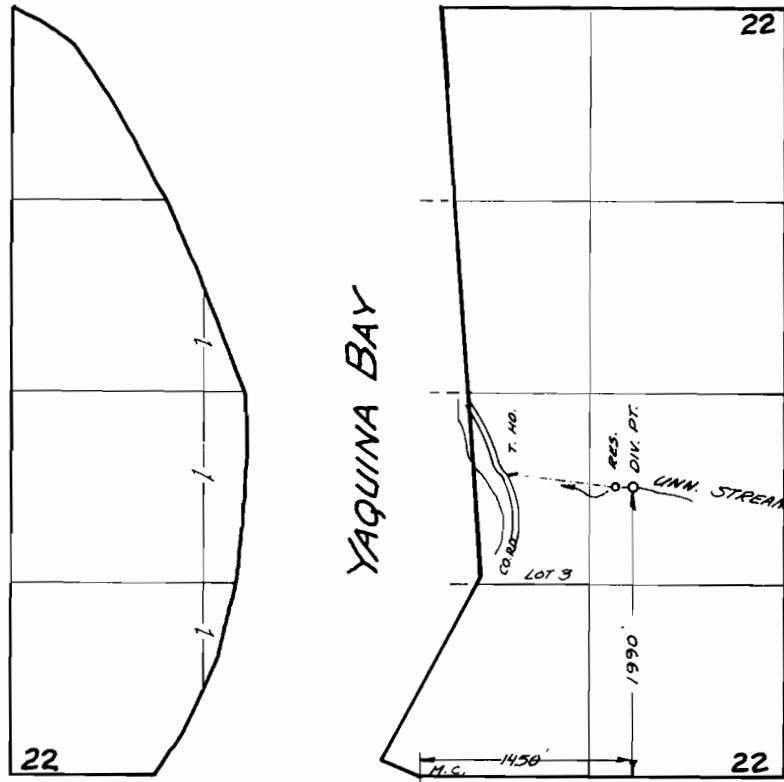

FINAL PROOF SURVEY
UNDER

Application No. 42602 Permit No. 31827
IN NAME OF

ROSCOE R and FLORENCE A REEVES

Surveyed Oct 8 1968, by V. Garner