


# T.11S.R.4 & 5W.W.M.

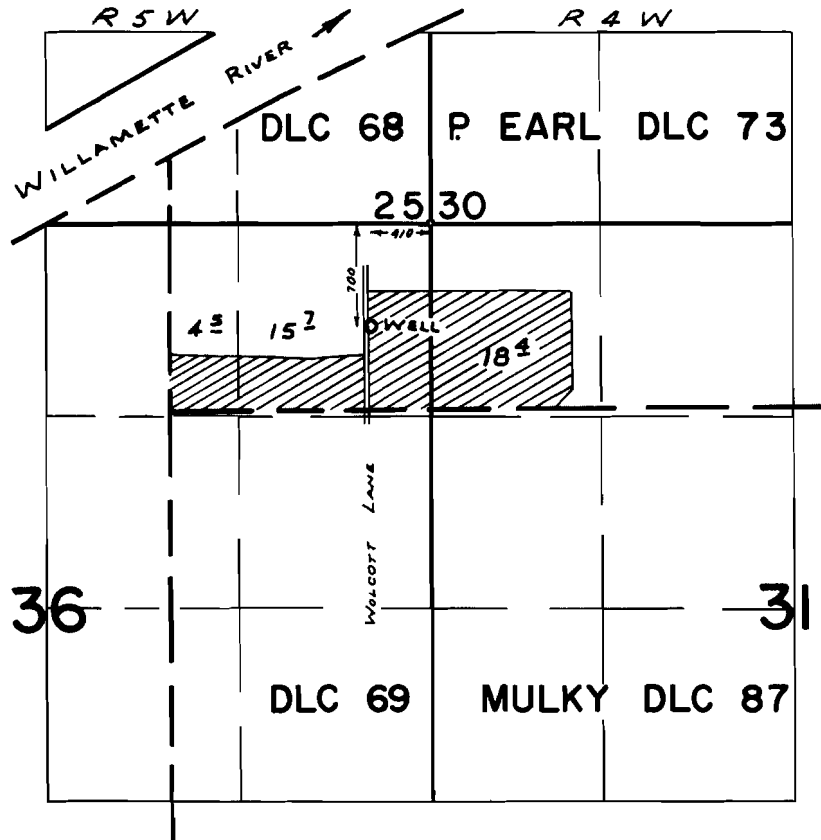

## FINAL PROOF SURVEY UNDER

Application No. G-2877 Permit No. G-2770  
IN NAME OF

WORTH BLACKER

Surveyed MAY 9, 1969, by W. RUPPERT