


T.13S.R.1E.W.M.

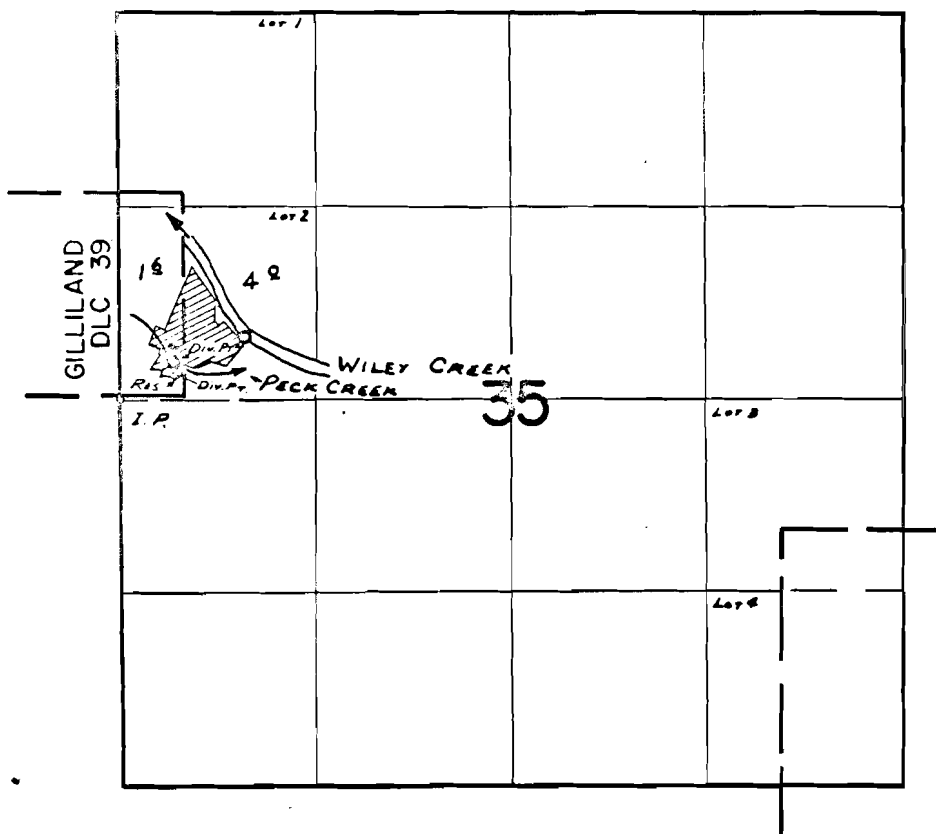

FINAL PROOF SURVEY UNDER

40176 29948
R-41233 R-4639
41523 30787
Application No. 44013 Permit No. 32901.....
IN NAME OF

GLENN A. PECK

Surveyed . APR. 24, 1969, by . W. RUPPERT.