


# T.13S.R.1E.W.M.

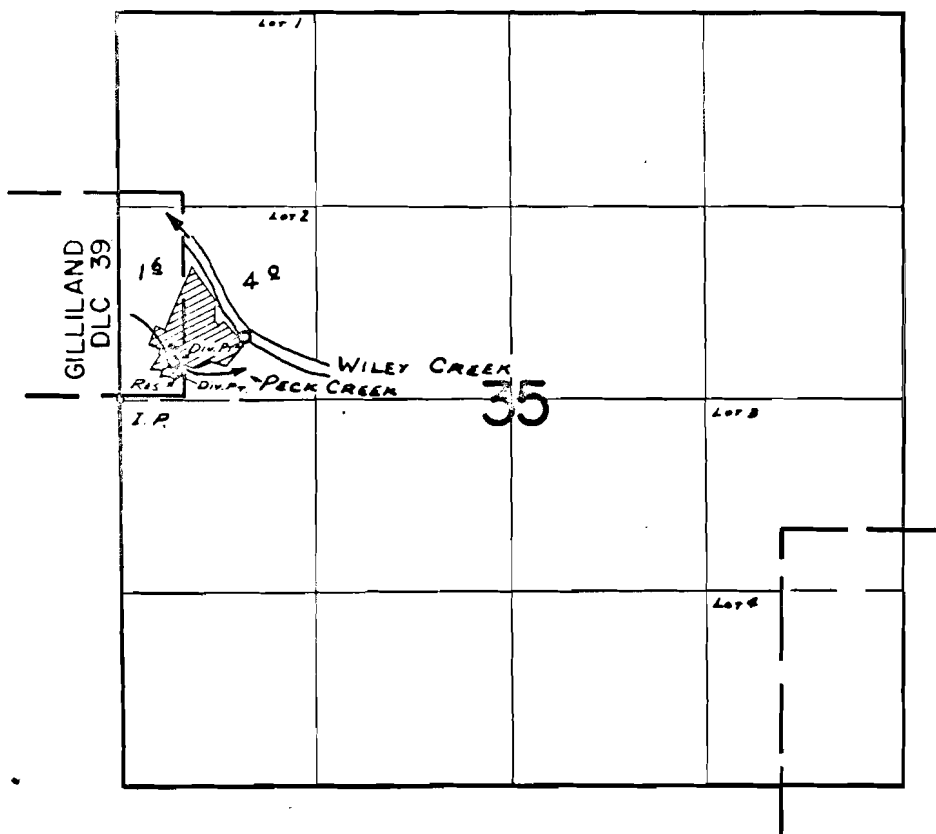

## FINAL PROOF SURVEY UNDER

40176                      29948  
R-41233                    R-4639  
41523                      30787  
Application No. 44013    Permit No. 32901.....  
IN NAME OF

GLENN A. PECK

Surveyed . APR. 24, 1969, by . W. RUPPERT.