


T. 11 S. R. 4 W. W. M.

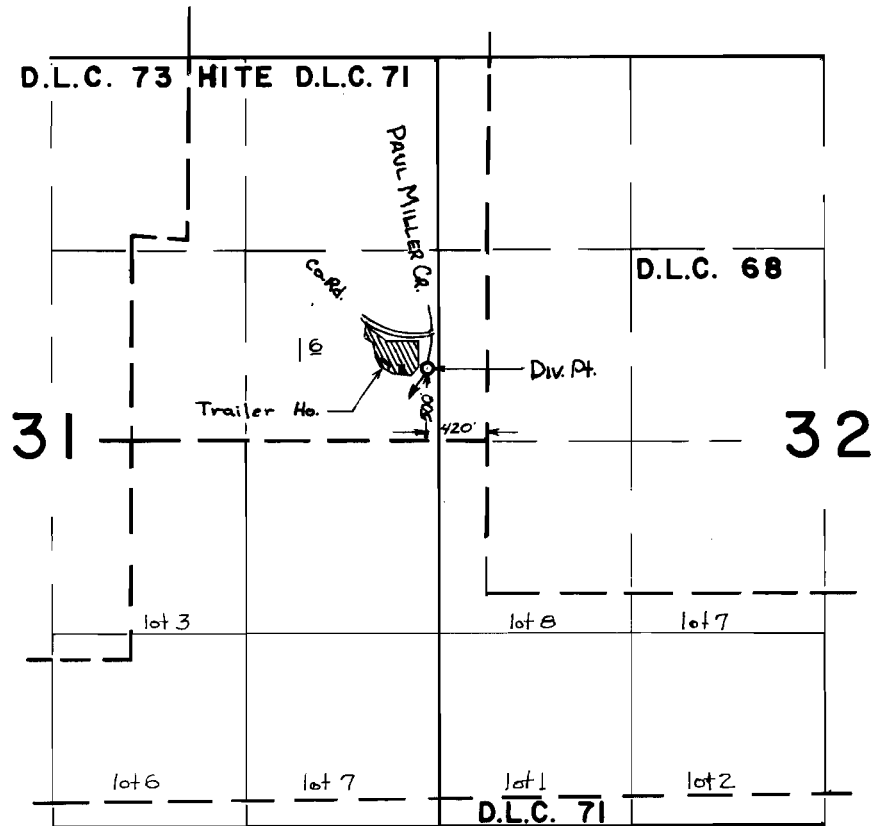

FINAL PROOF SURVEY
UNDER

Application No. 35101..... Permit No. 27483.....
IN NAME OF

..... EDWARD L. McFARLAND

Surveyed 14 AUG . 1969 , by W. J. RUPPERT.