


T. 13 S. R. 3 W. W.M.

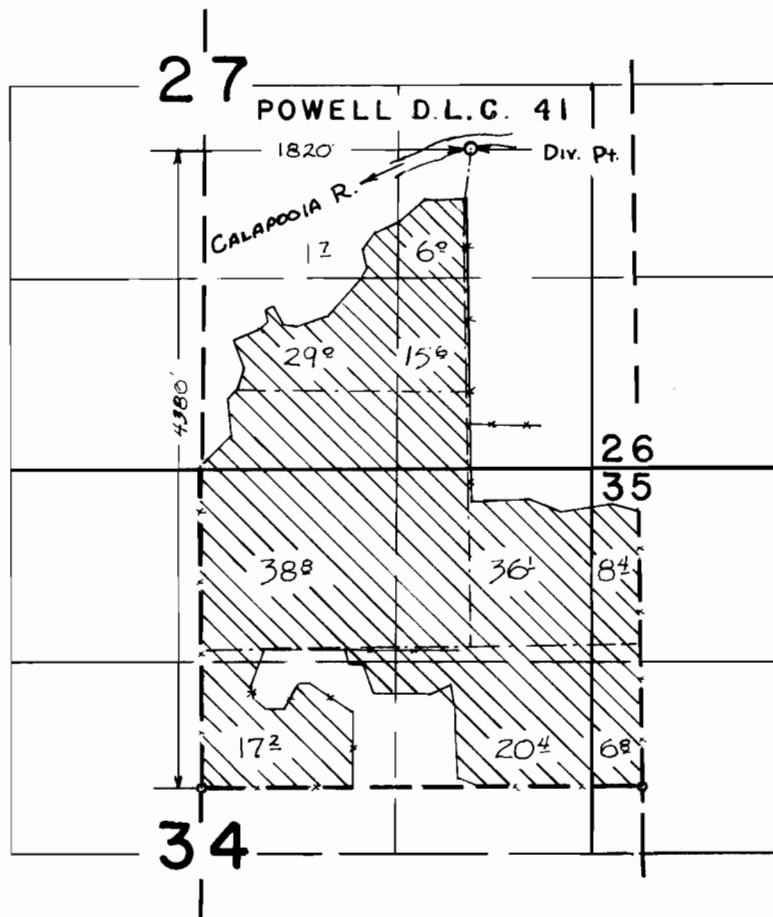

FINAL PROOF SURVEY UNDER

Application No. 38867 Permit No. 28904
IN NAME OF

GARY L. & MILDRED N. KNUTHS

Surveyed 13 AUG. 1969, by W. J. RUPPERT