


T. 13S.R. 1E.W.M.

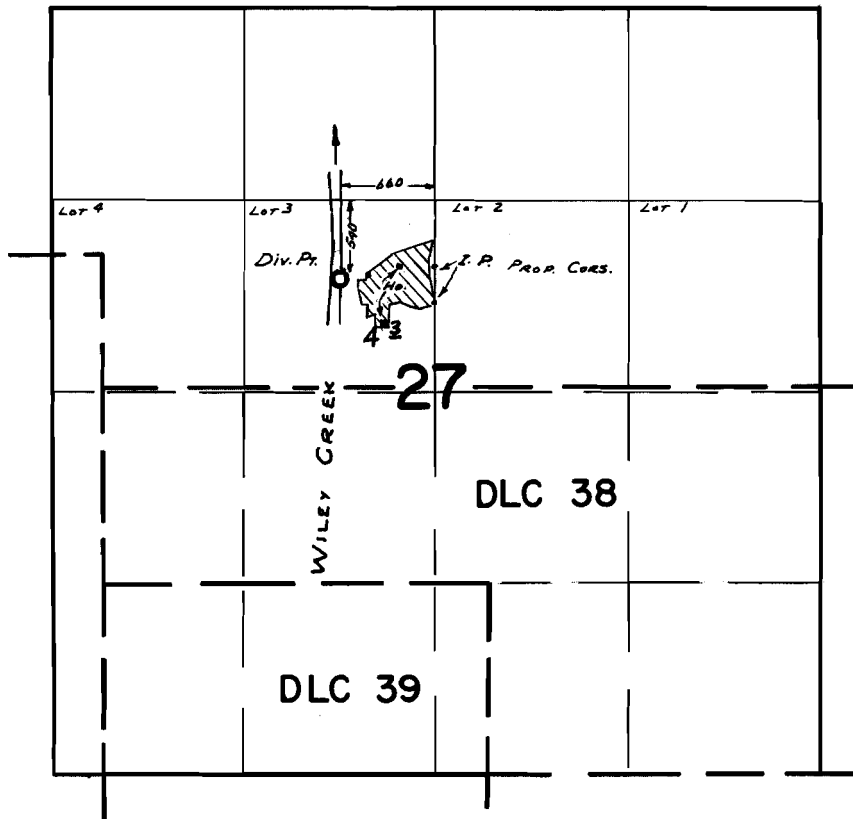

**FINAL PROOF SURVEY**  
UNDER

Application No. 40528... Permit No. 30186.....  
IN NAME OF

CHESTER O. ROYER

Surveyed MAY 7, 1969, by W. RUPPERT...