


T.30S.R.14W.W.M.

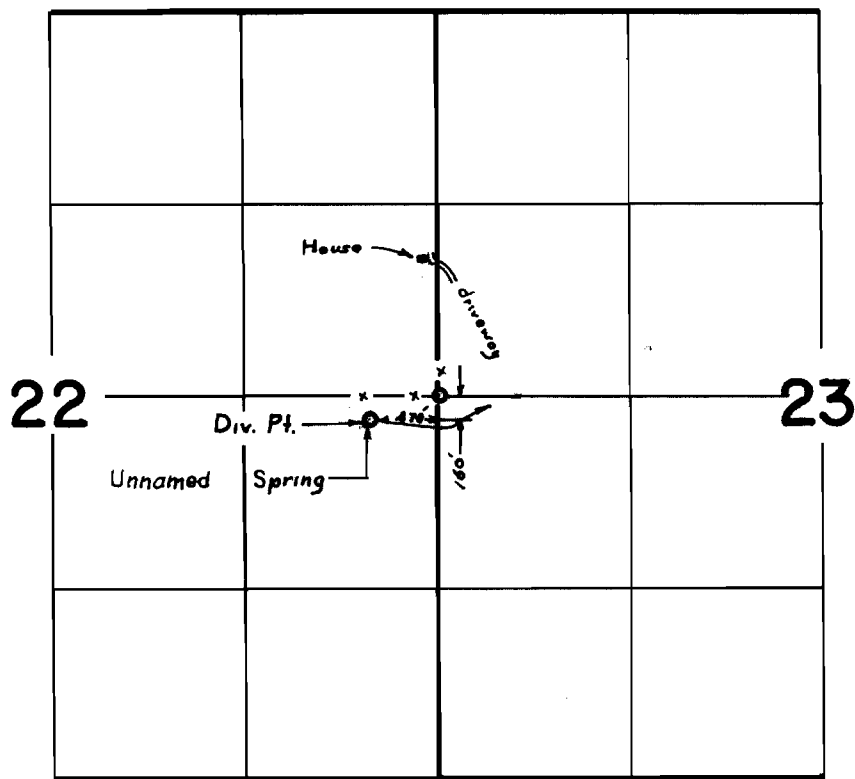

FINAL PROOF SURVEY
UNDER

Application No. 41864 Permit No. 31113

IN NAME OF
SYLVIA IRENE PENBERTHY,
guardian, SANDRA IRENE PENBERTHY, minor

Surveyed May.16. 1969, by L.E. Gould