


T.8S. R.4W. W.M.

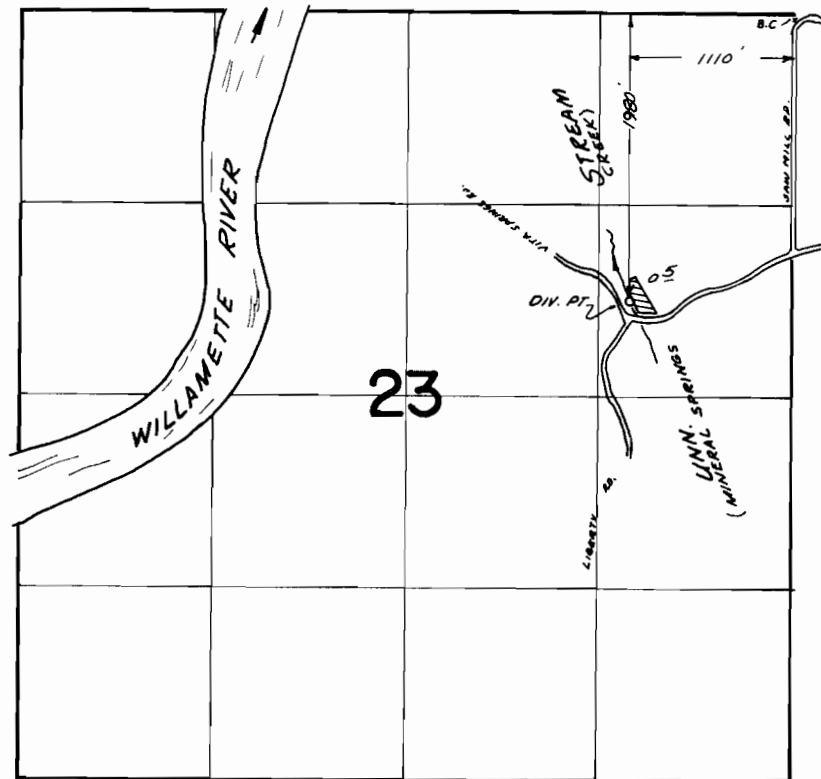

**FINAL PROOF SURVEY**  
UNDER

Application No. 42628 Permit No. 31222  
IN NAME OF

LESLIE L. CHASTAIN

Surveyed April 26, 1968, by V. GARNER