


T. 7 S. R. 4 W. W.M.

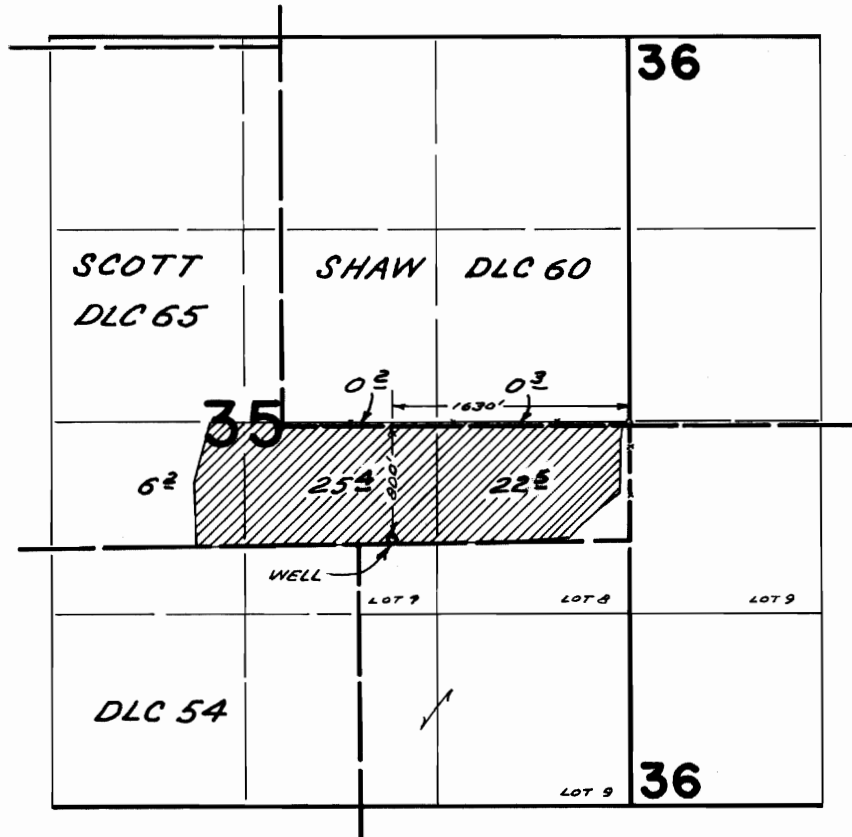

FINAL PROOF SURVEY UNDER

Application No. G-3541 Permit No. G-3331
IN NAME OF

WALTER BROWN

Surveyed APR. 25 1969, by D. BUELL