


# T. 6 & 7 S. R. 4 W. W.M.

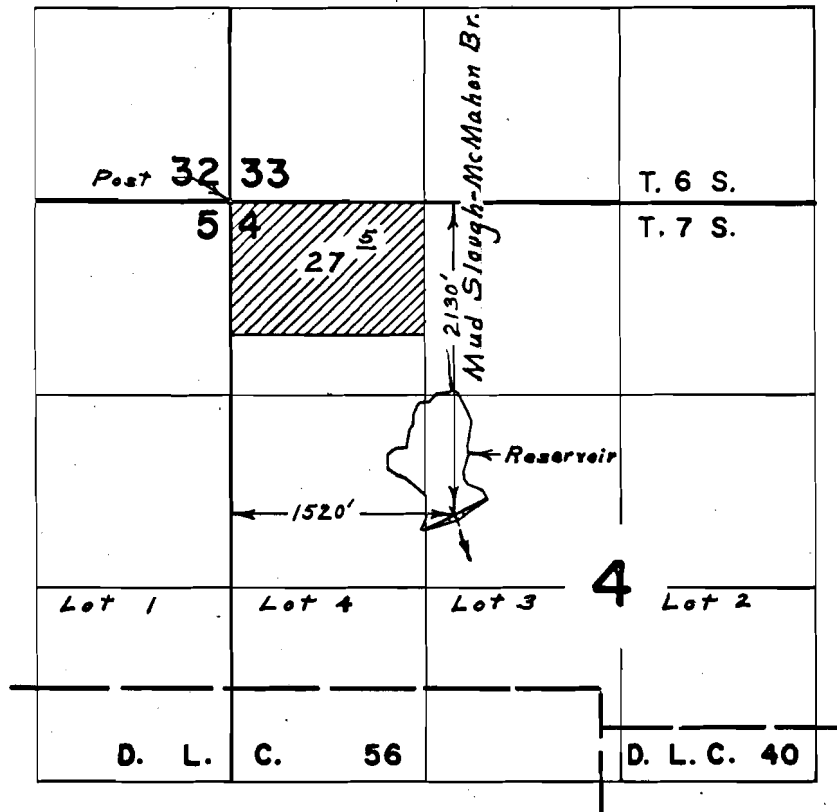

## FINAL PROOF SURVEY UNDER

R-38040                      R-3152  
Application No. 38041      Permit No. 28379

IN NAME OF

**EMIL MARX**

Surveyed Oct. 18, 1968, by W. J. Ruppert.