


T. 6 & 7 S. R. 4 W. W.M.

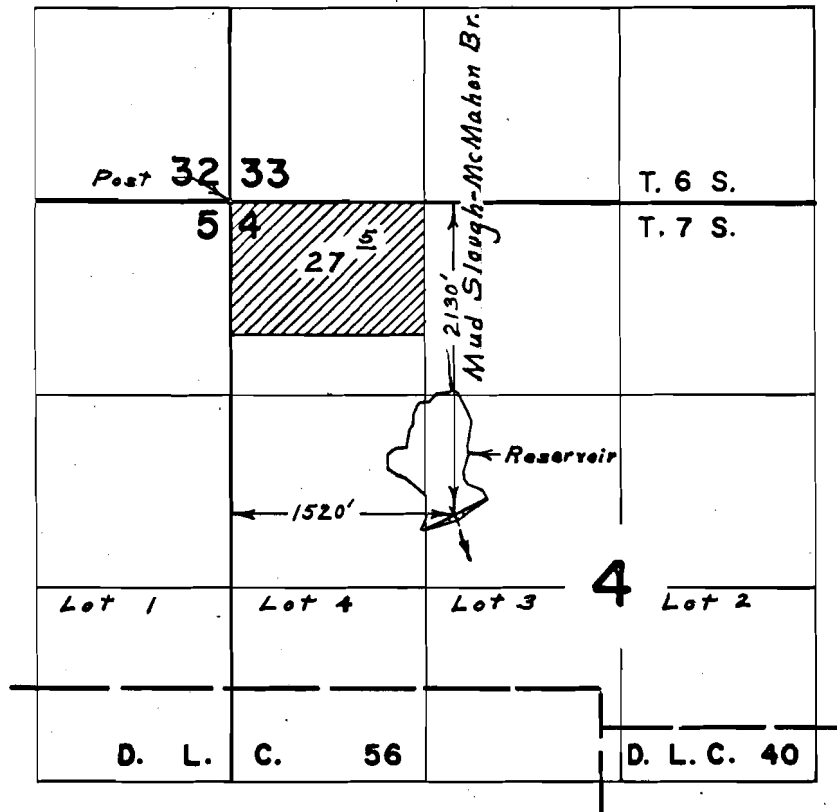

FINAL PROOF SURVEY UNDER

R-38040 R-3152
Application No. 38041... Permit No. 28379..

IN NAME OF

EMIL MARX

Surveyed Oct. 18., 1968, by W. J. Ruppert.