


T-6456

T. 8 S. R. 4 W. W. M.

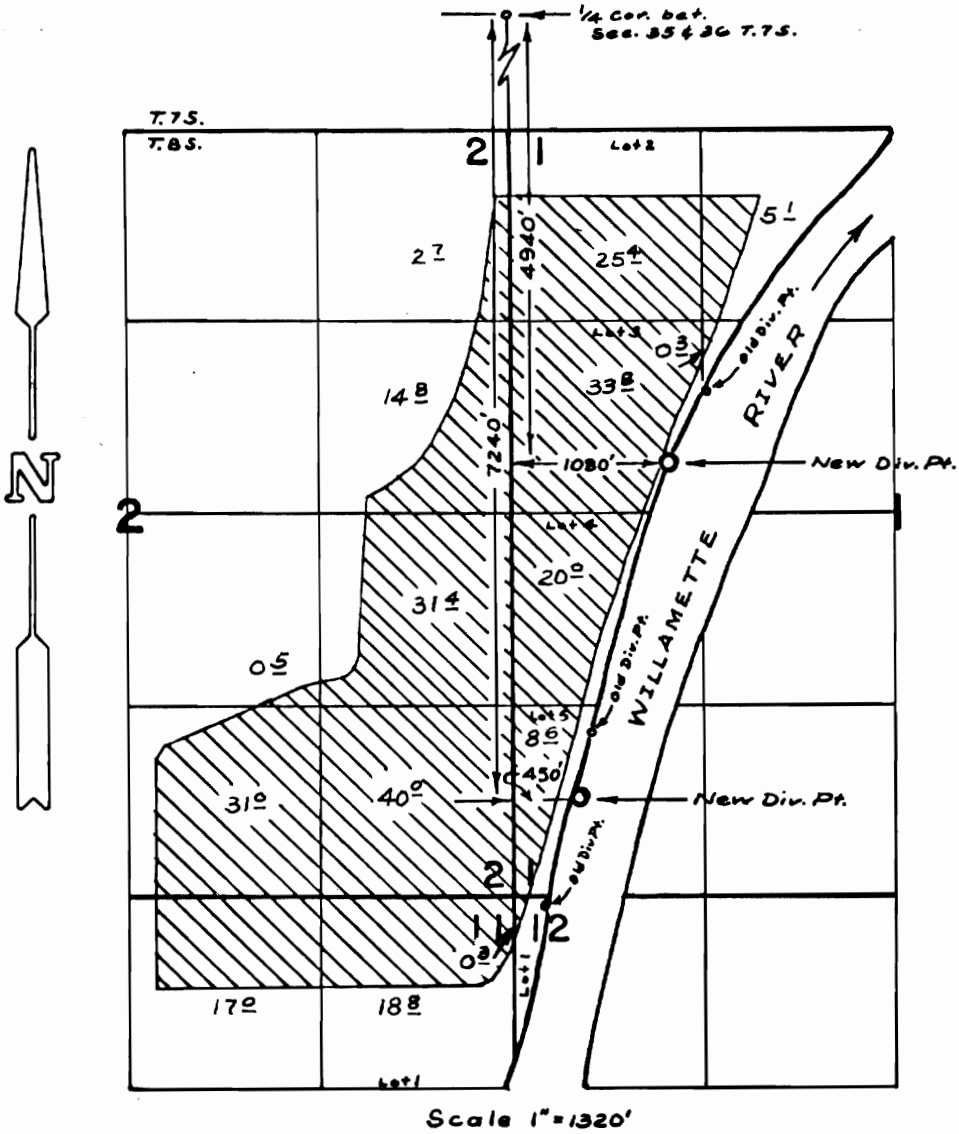

CHANGE IN POINT OF DIVERSION
MAP FOR
PERMIT No. 29117
GREEN VILLA FARMS

THE PREPARATION OF THIS MAP IS FOR THE PURPOSE OF IDENTIFYING THE LOCATION OF THE WATER RIGHT ONLY AND HAS NO INTENT TO PROVIDE DIMENSIONS OR LOCATION OF PROPERTY OWNERSHIP LINES.

