


T.6S.R.7W.W.M.

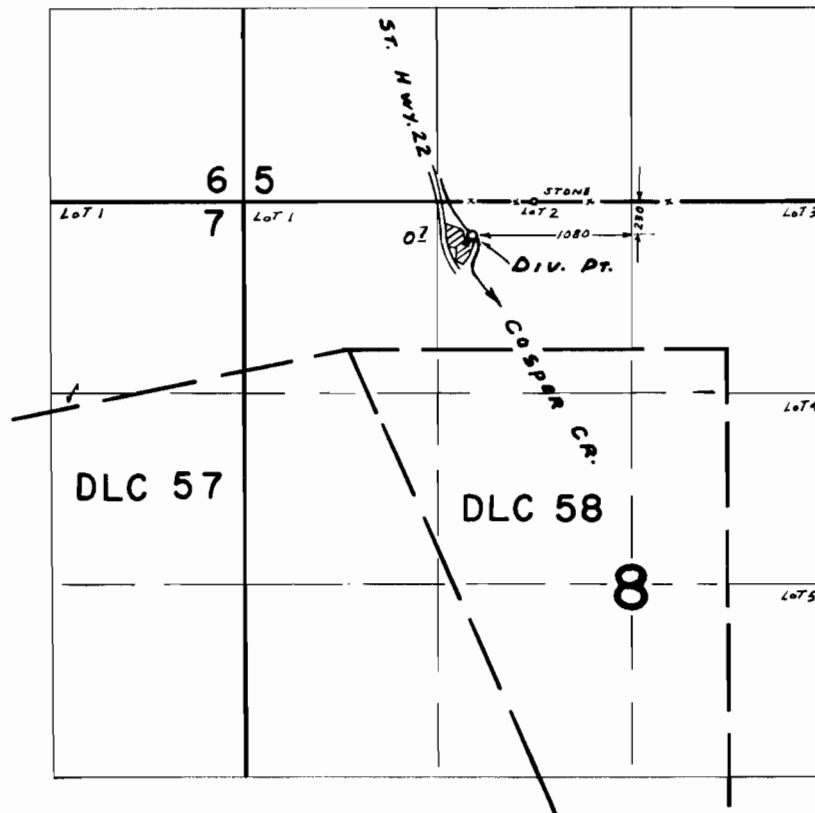

FINAL PROOF SURVEY UNDER

Application No. 39153 Permit No. 29131
IN NAME OF

GEORGE J. KOCHIS

Surveyed *Nov. 18, 1969*, by *R. Mucken*