


T. 7 S. R. 4 W. W. M.

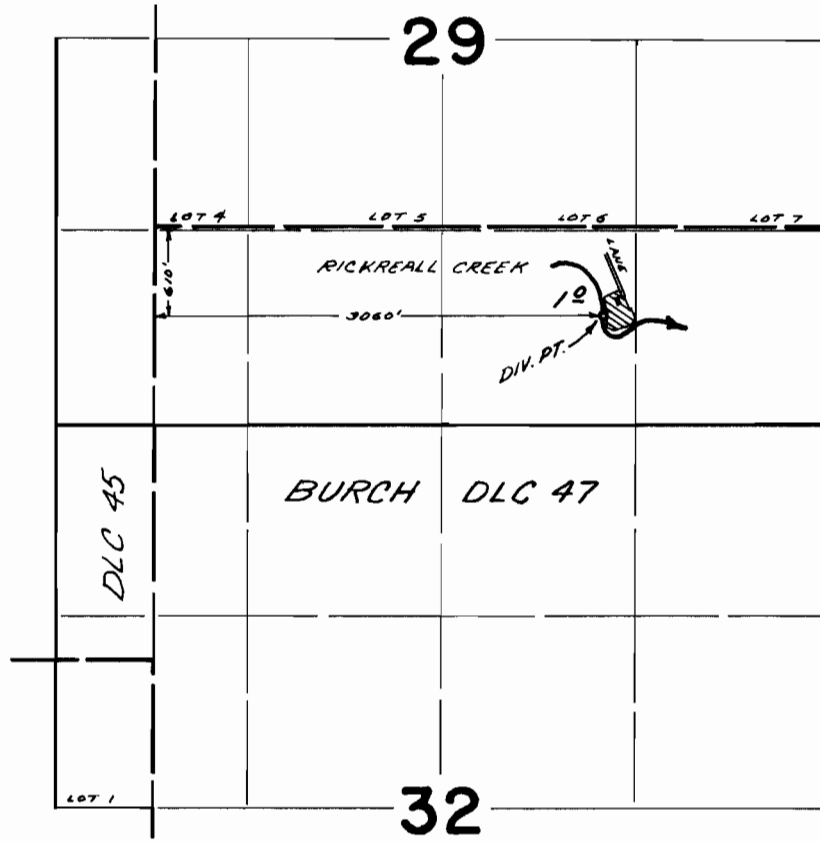

FINAL PROOF SURVEY UNDER

Application No. 42054 Permit No. 31478
IN NAME OF

PAUL LEROY & JOAN MAY SMULL

Surveyed JUN. 30 1969, by D. BUELL