


T.6S.R.6W.W.M.

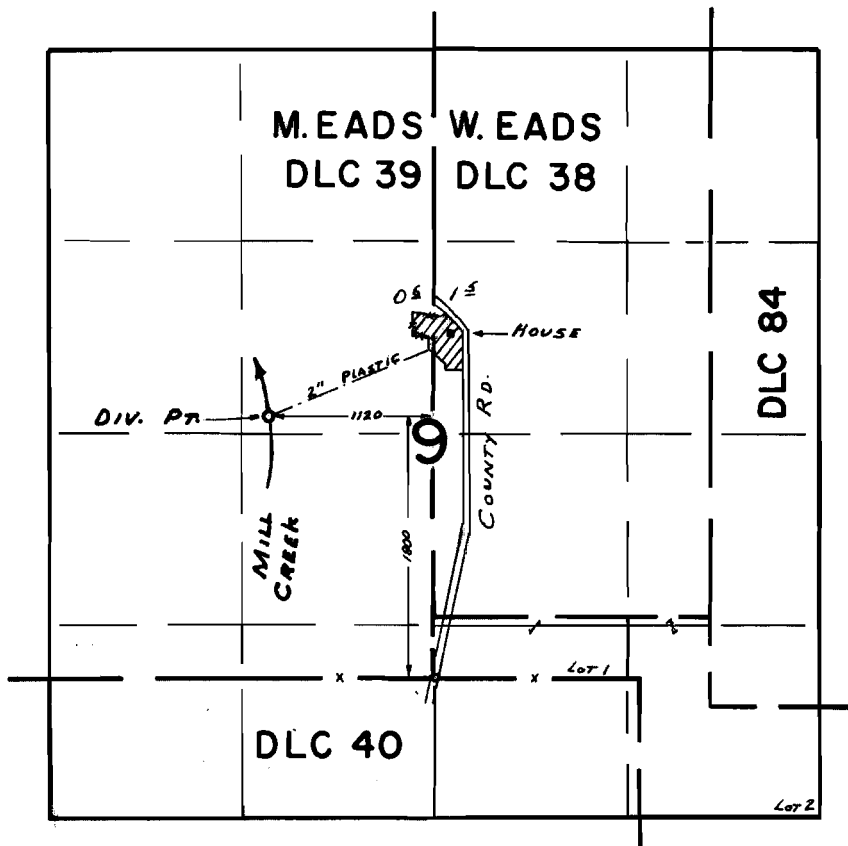

FINAL PROOF SURVEY UNDER

Application No. 43870 Permit No. 32871
IN NAME OF

MRS. GERTRUDE B. SWARTZ

Surveyed Nov. 13 1969, by D. BULL