


T.6S.R.7W.W.M.

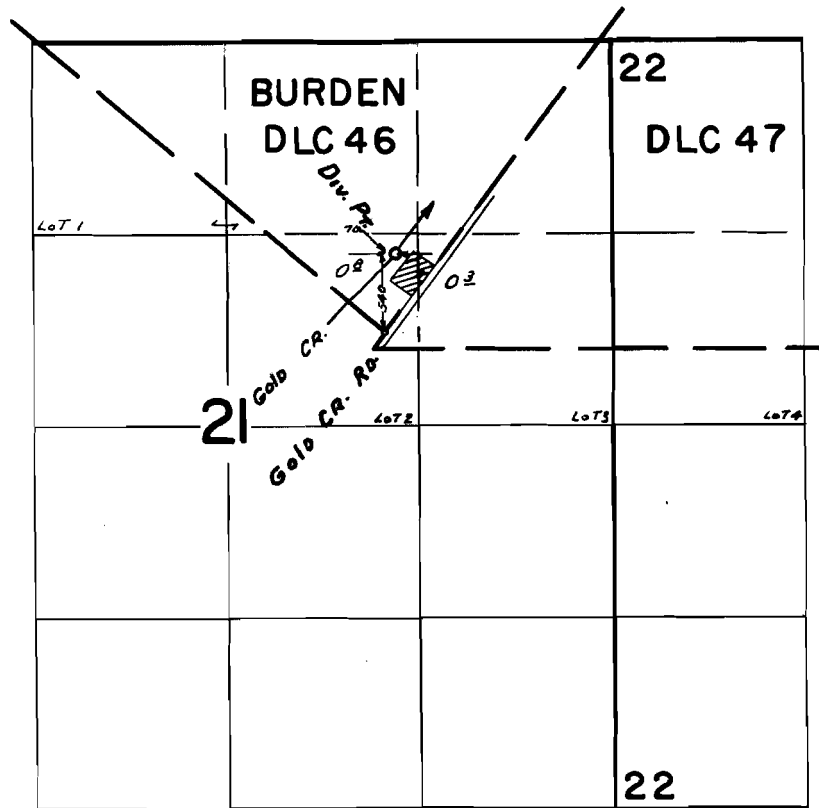

FINAL PROOF SURVEY
UNDER

Application No. 44684 Permit No. 33455
IN NAME OF

LLOYD A. LEWIS

Surveyed Nov. 18, 1969, by R. Mucken