


G-32187

49481  
36802

# T.5N.R.29E.W.M.

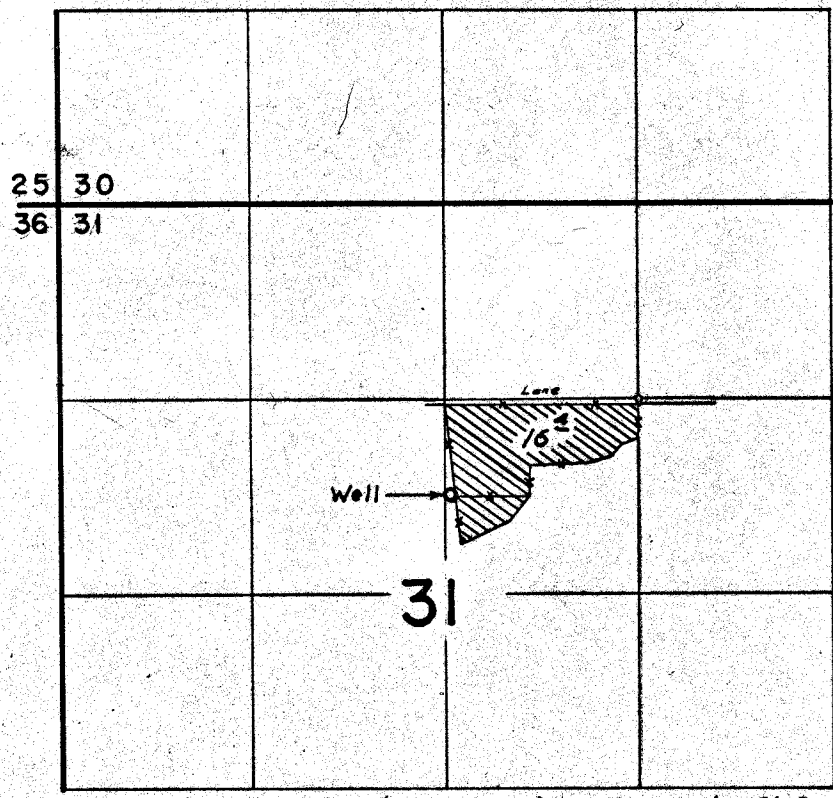

Div. Pt. located: 650 ft. S. & 1280 ft. W. from NE cor SW & NE & Sec. 31.

## FINAL PROOF SURVEY UNDER

Application No. G-5433 Permit No. G-3218  
IN NAME OF

HERMAN H. & PHYLLIS E. SCHULTZ

Surveyed Jul. 12, 1969, by L. E. Gould