


T.5N.R.30E.W.M.

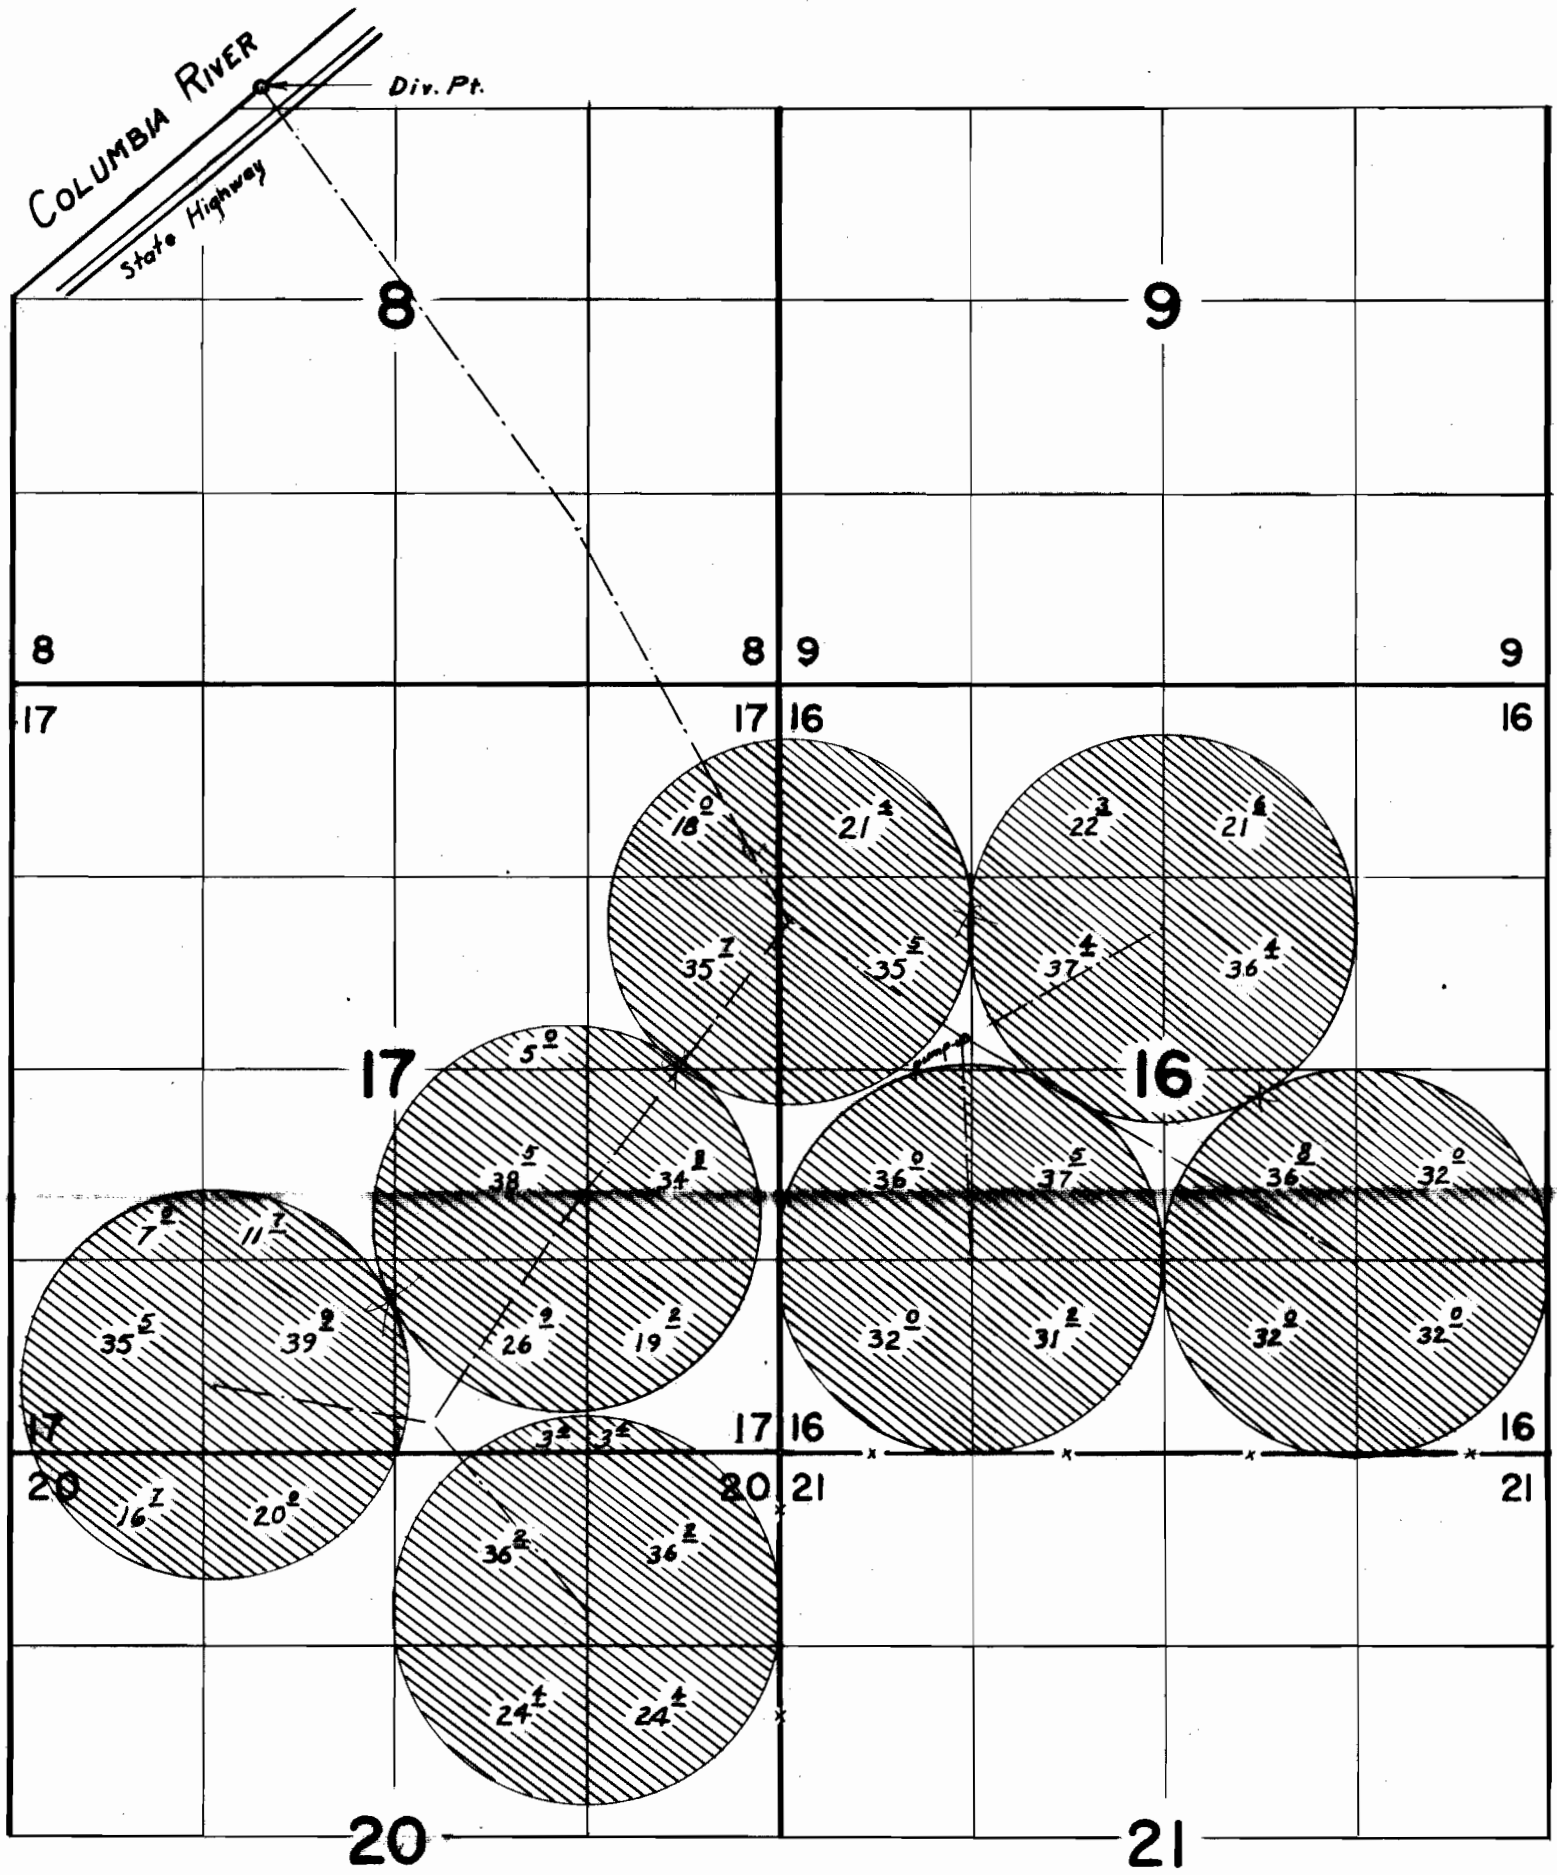

Div. Pt. located : 9360 ft. N. & 3530 ft. W. from SE. cor. Sec. 17.

**FINAL PROOF SURVEY**  
UNDER

Application No. 40223 Permit No. 30000

IN NAME OF

**ERVIN EDMUNDS**

Surveyed July 17, 1969, by L. E. Gould