


T. 2 S. R. 40 E. W.M.

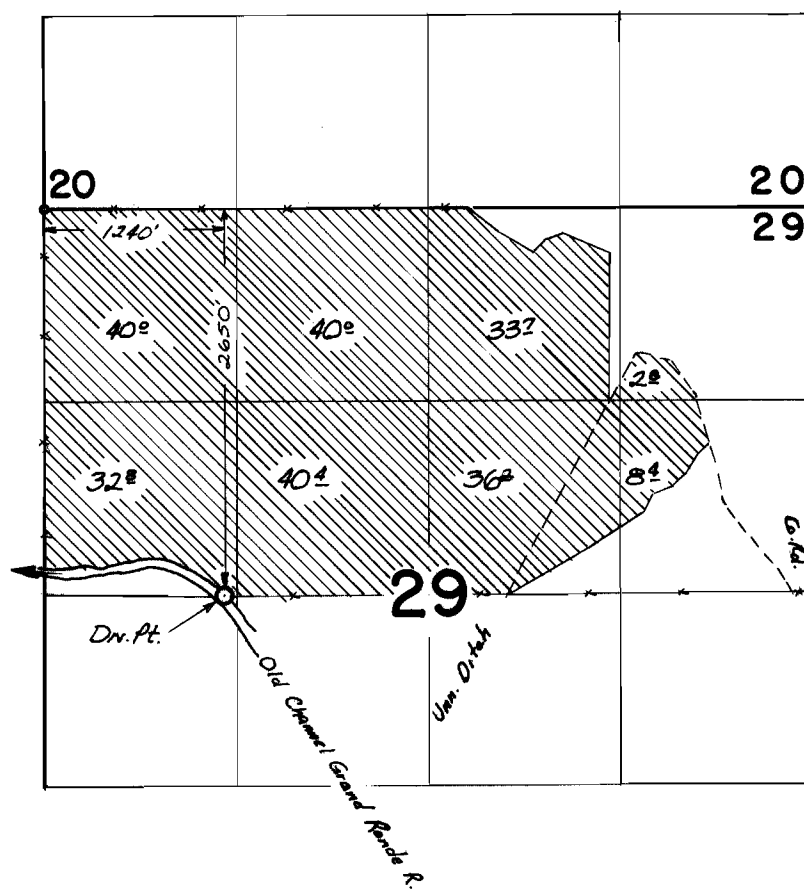

FINAL PROOF SURVEY UNDER

Application No. 38529 Permit No. 28720
IN NAME OF

MANFORD J. MORRIS

Surveyed 20 AUG. 1969, by W. J. RUPPERT