


T. 1 N. R. 38 E. W. M.

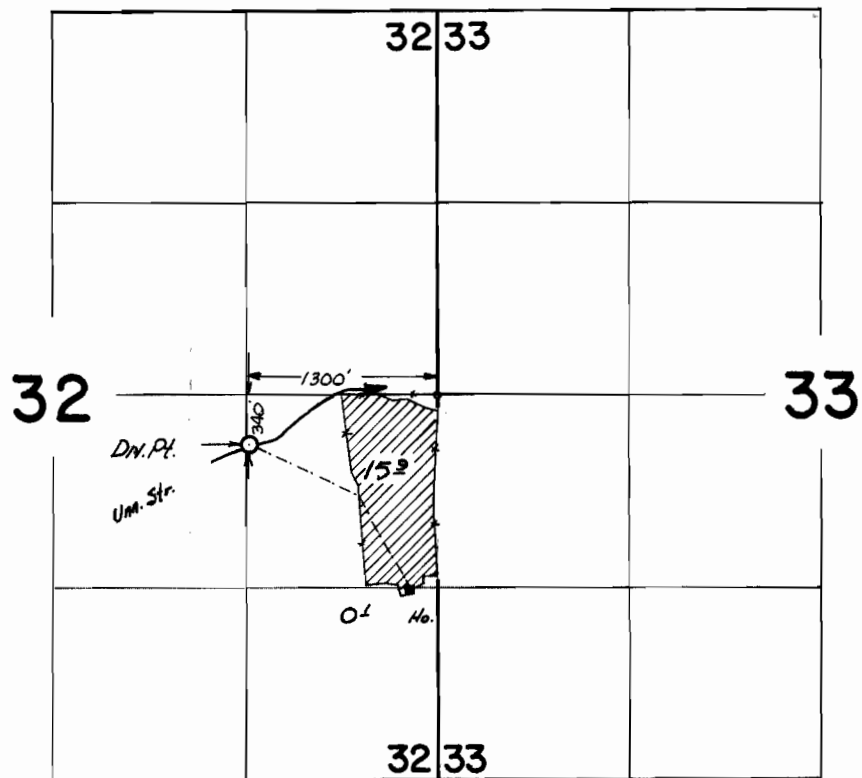

FINAL PROOF SURVEY
UNDER

Application No. 39300 Permit No. 29269
IN NAME OF

MAX FERGUSON

Surveyed 25 AUG 1969, by W. J. RUPPERT