


100 hp:

1/2 mile 5" 4"

32 spindles

T.2S. R.40E.W.M.

7/16

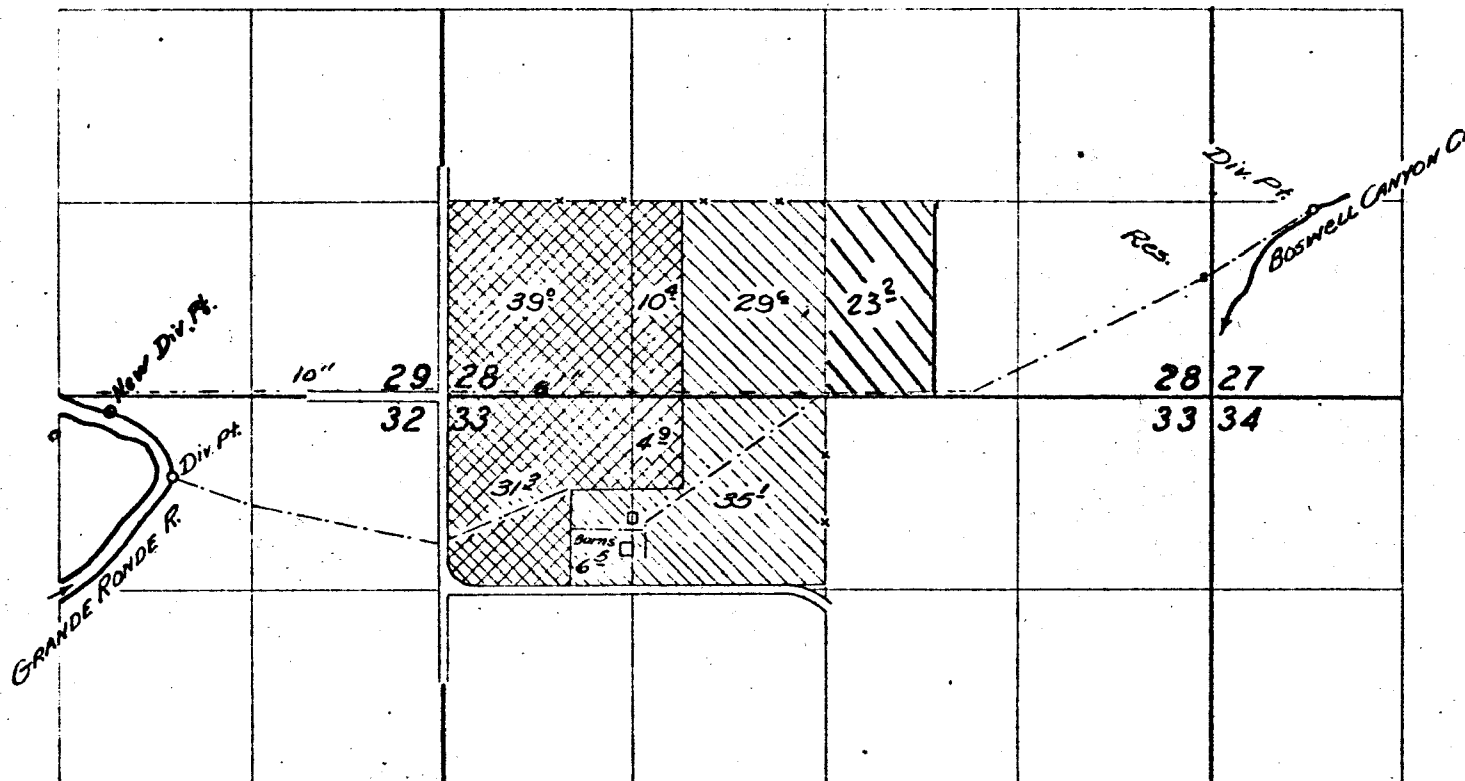

FINAL PROOF SURVEY

UNDER

Application No. R-24561 24609 25453 Permit No. R-1025 19382 22282

IN NAME OF

HARLOW C. & MELBA HONSTADT

Surveyed Aug 13, 1959, by A. B. Smith

Application No. 40691
Permit No. 30305