


T.1 N. & 1 S. R. 38 E. W.M.

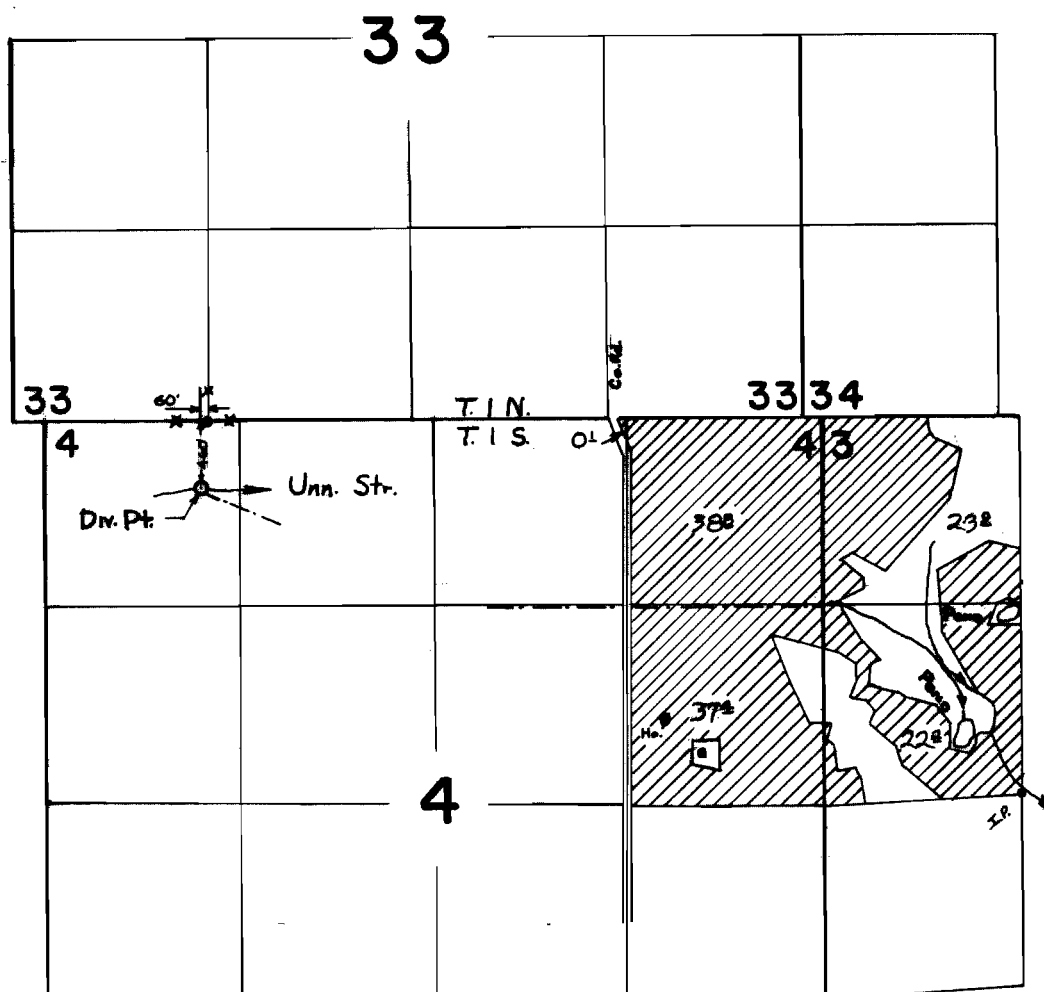

FINAL PROOF SURVEY
UNDER

TRANSFER F 62
Application No. 42031 Permit No. 31109
IN NAME OF

FLOYD A. FEIK

Surveyed 17 JULY 1969, by W. J. RUPPERT