


T. 1 N. & 1 S. R. 38 E. W.M.

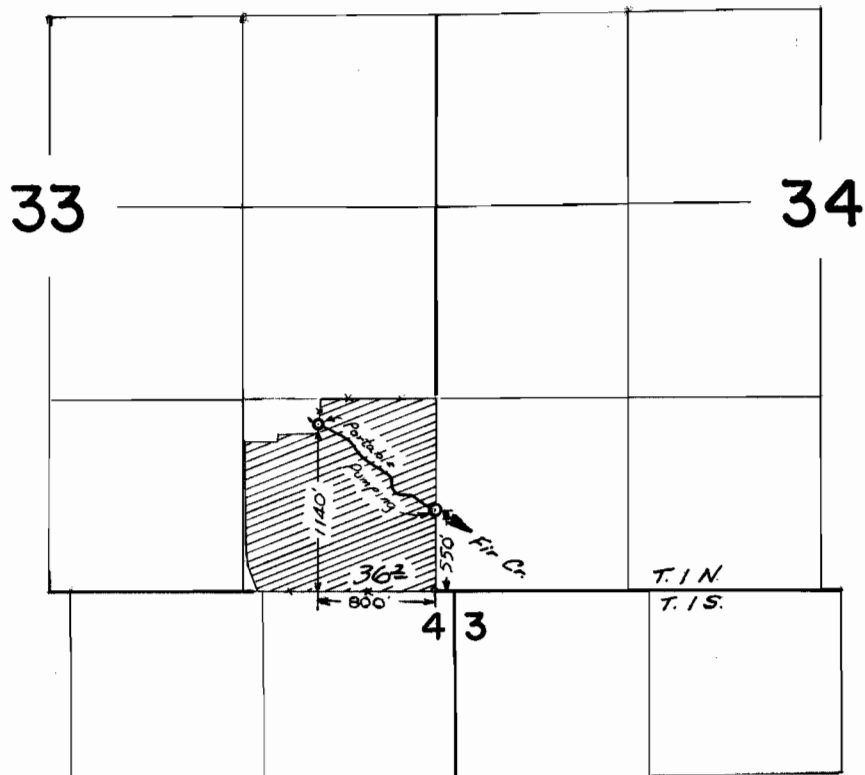

FINAL PROOF SURVEY
UNDER

Application No. **42865** Permit No. **32037**
IN NAME OF

NORA F. HANSON

Surveyed **27 AUG 1969**, by **W. J. RUPPERT**