
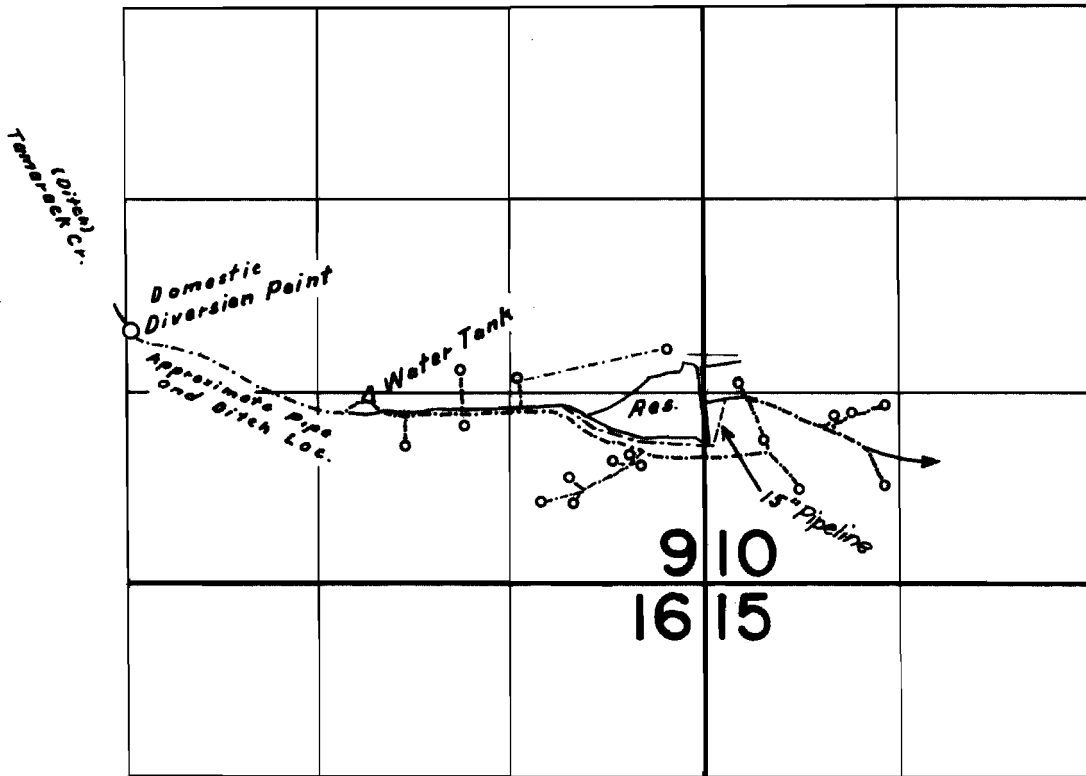


T.2S. R.11E. W.M.

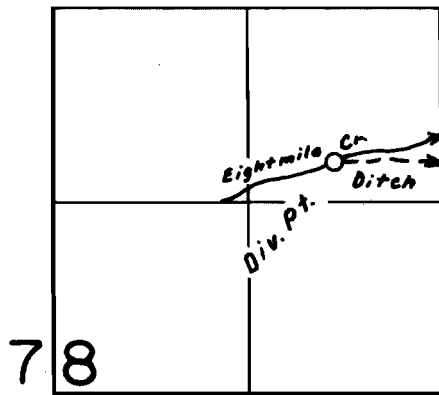

o = Water Outlets

FINAL PROOF SURVEY UNDER

R-37124 R-3200
Application No. 37125 Permit No. 28547
IN NAME OF

PORTLAND AREA COUNCIL, B. S. A.

Surveyed Oct. 20, 23, 24, 26, by C. J. Gardner
1964