


T.15S.R.5W.W.M.

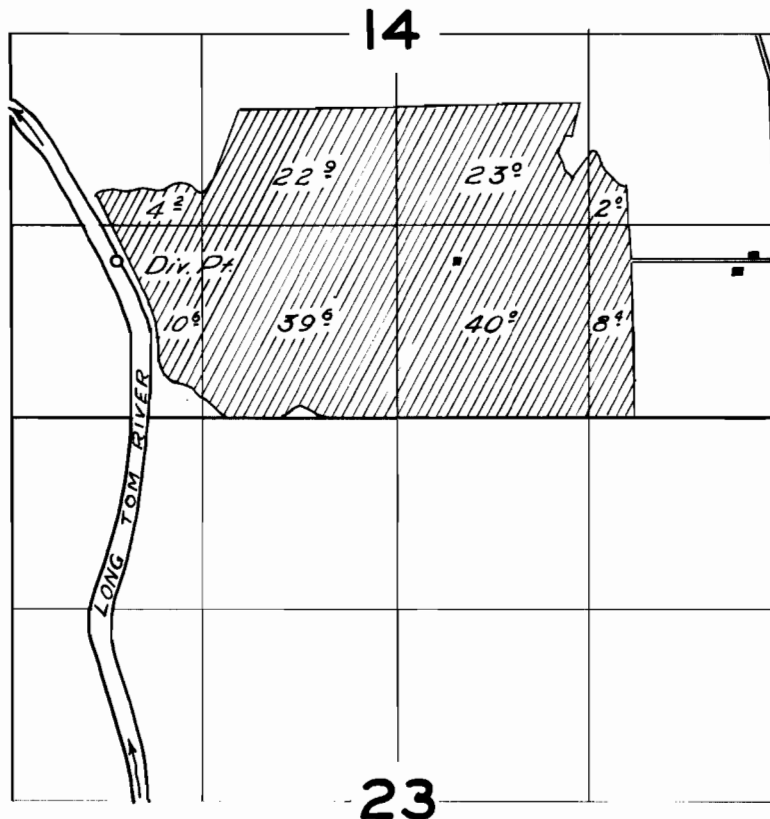

FINAL PROOF SURVEY  
UNDER

Application No. 30101 Permit No. 23765  
IN NAME OF

WALTER P. HUBBARD

Surveyed 16 April 1957, by *W. H. Hilby*