


RECEIVED

JAN 03 1964

WATER RESOURCES DEPT.
SALEM, OREGON

T. 10 S. R. 2 W. W. M.

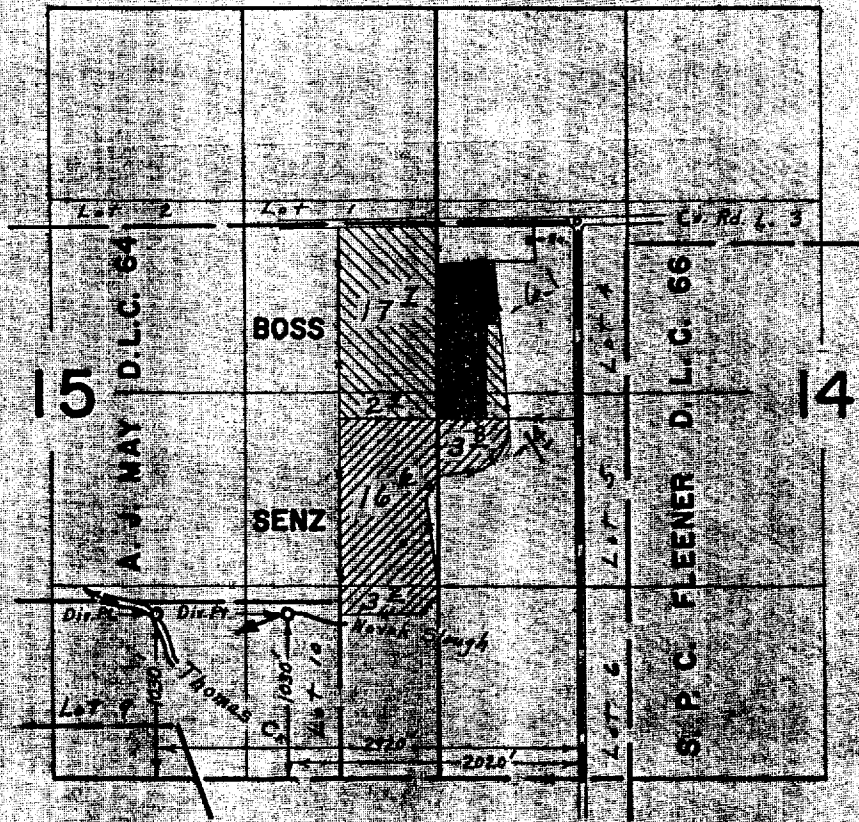

FINAL PROOF SURVEY
UNDER

Application No. 37535 Permit No. 279273

IN NAME OF

DEAN R. BOSS

MABEL D. ARNOLD SENZ AND/OR FRANK A. SENZ

Surveyed Oct. 30, 1967, by L. E. Gauld