


T.7S.R.1E.W.M

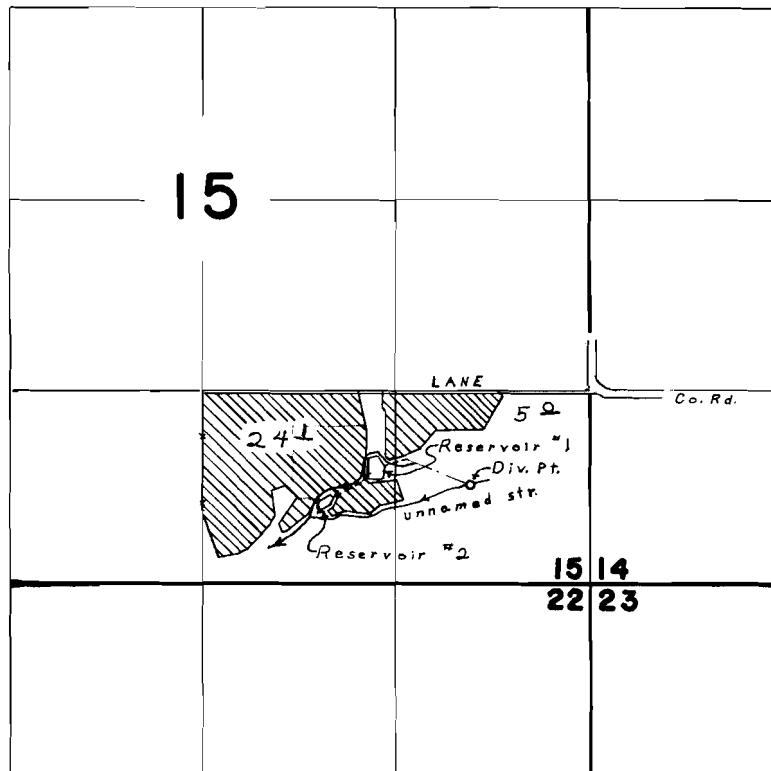

Div. Pts located: 560' S & 1130' E; 820' S & 790' E;
640' S & 1830' E; from NW cor. SW $\frac{1}{4}$, SE $\frac{1}{4}$

FINAL PROOF SURVEY
UNDER

R-39994 R-4133
Application No. 39995 Permit No. 29792
IN NAME OF

MR. MIRZA ALDEN WATERSON

Surveyed **JULY 26 1968** by **L. E. GOULD**