



T. 7 & 8 S. R. 4 W. W. M.

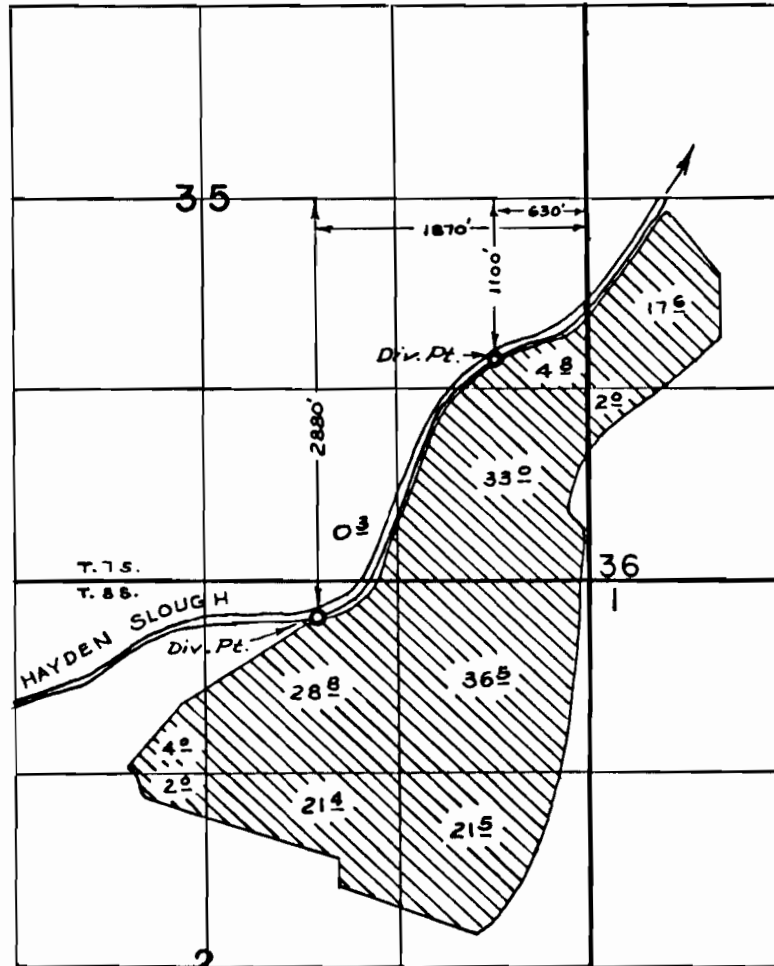

Scale 1" = 1320'

CORRECTION MAP  
FOR  
APPLIC. No. 11918 PERMIT No. 8298  
GREEN VILLA FARMS

THE PREPARATION OF THIS MAP IS FOR THE  
PURPOSE OF IDENTIFYING THE LOCATION  
OF THE WATER RIGHT ONLY AND HAS NO  
INTENT TO PROVIDE DIMENSIONS OR LOCATION  
OF PROPERTY OWNERSHIP LINES.

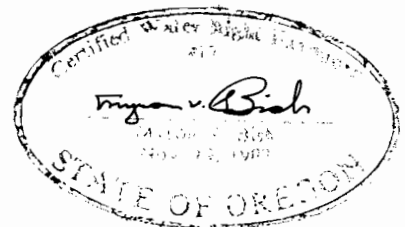

81611

34

35

36

T. 7 S. R. 4 W.  
T. 8 S. R. 4 W.

3

2

10

10

15

10

11

3

25

3

2

30

39

12 chs.

20

Pump No. 1

5

5

20 chs.

Pump No. 2

Dam

Pump No. 3

38

Hayden Lake

Hayden slough

South Lake

Willamette River

PLAT  
OF  
E.C. HORST CO'S LAND  
IN  
POLK COUNTY  
OREGON  
SHOWING IRRIGATION SYSTEM  
KNOWN AS  
NORTH SLOUGH SYSTEM

Edw. J. Himes  
Engr.

Scale 1 IN. = 20 Chs.

8298

