


T.6S.R.10W.W.M.

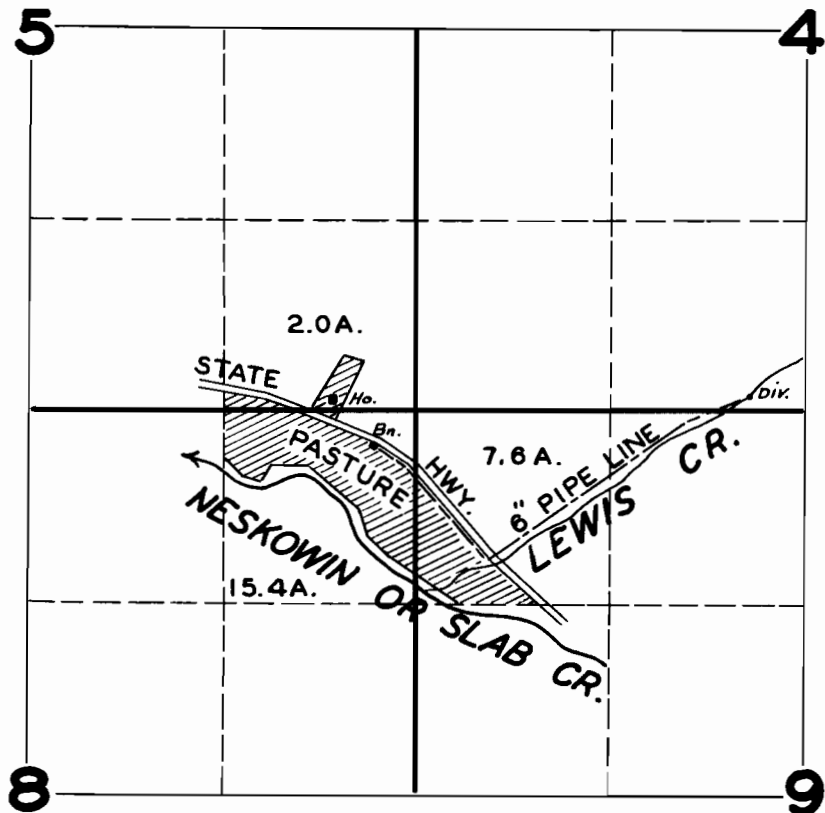

FINAL PROOF SURVEY
UNDER

Application No. 17711 Permit No. 13571
IN NAME OF

C. I. JONES

Surveyed SEP. 7, 1948, by JAS. E. BUNNELL