


T. 15. R. 39E. W.M.

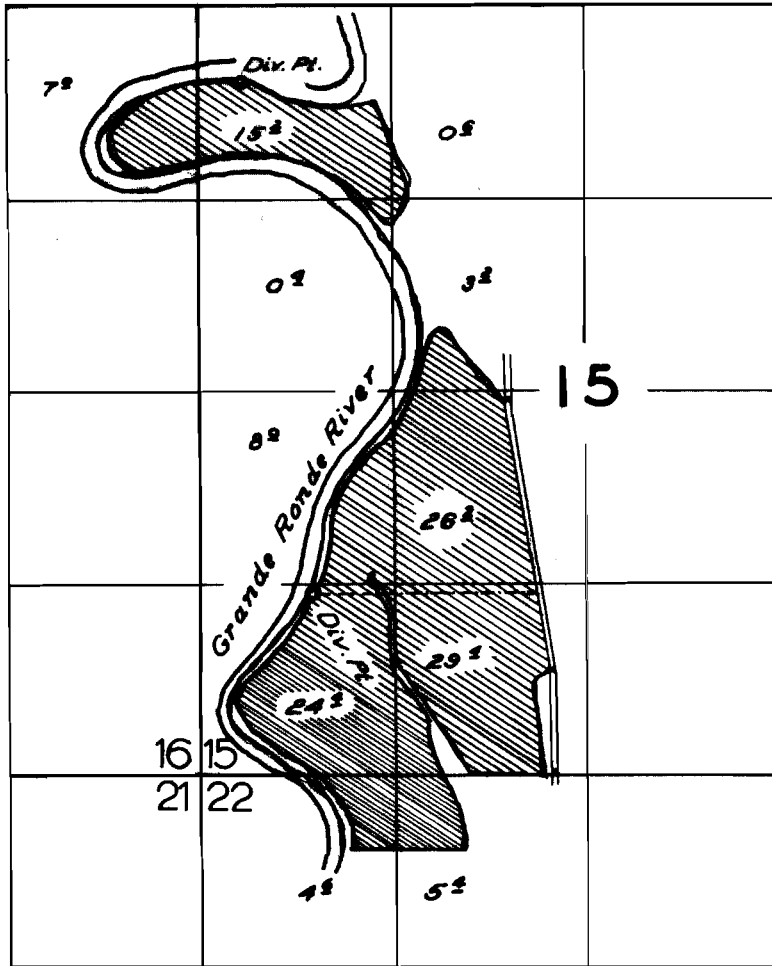

**FINAL PROOF SURVEY**  
UNDER

Application No. 24000... Permit No. 18930...  
IN NAME OF

*Chase M. & Mabel S. Bohnenkamp*

Surveyed Aug. 6. 1952, by R.H. Jackson.