


# T.13S.R.37E.W.M.

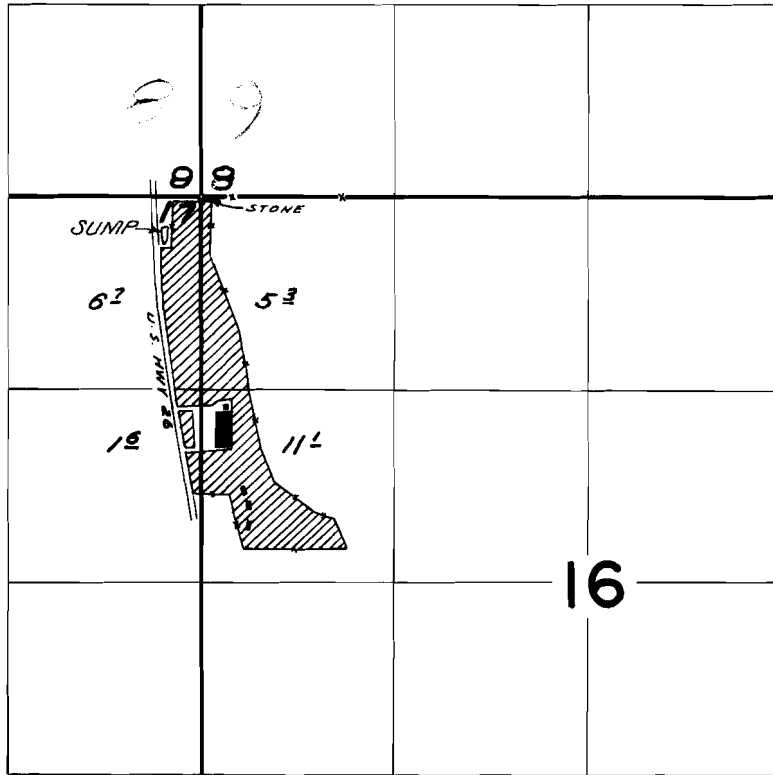

SUMP LOCATED 260' S. & 250' W. FROM NE COR. SEC. 17

## FINAL PROOF SURVEY UNDER

Application No. G-2901 Permit No. G-2728  
IN NAME OF

BAKER COUNTY SCHOOL DISTRICT, 30-J

Surveyed JUL 14 1969, by D. BUELL