


T.9S.R.40E.W.M.

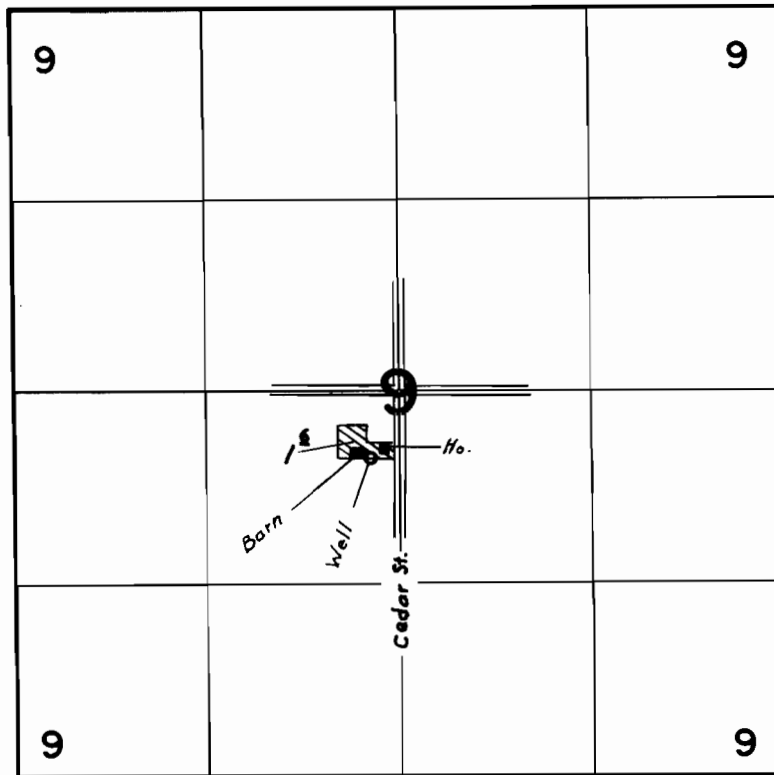

Well located: 470 ft. S. & 200 ft. W. from center Sec. 9.

FINAL PROOF SURVEY UNDER

Application No. G-3508 Permit No. G-3302
IN NAME OF

JOHN HESKETH

Surveyed Oct. 23, 1969, by L. E. Gould