


T.7S.R.39E.W.M.

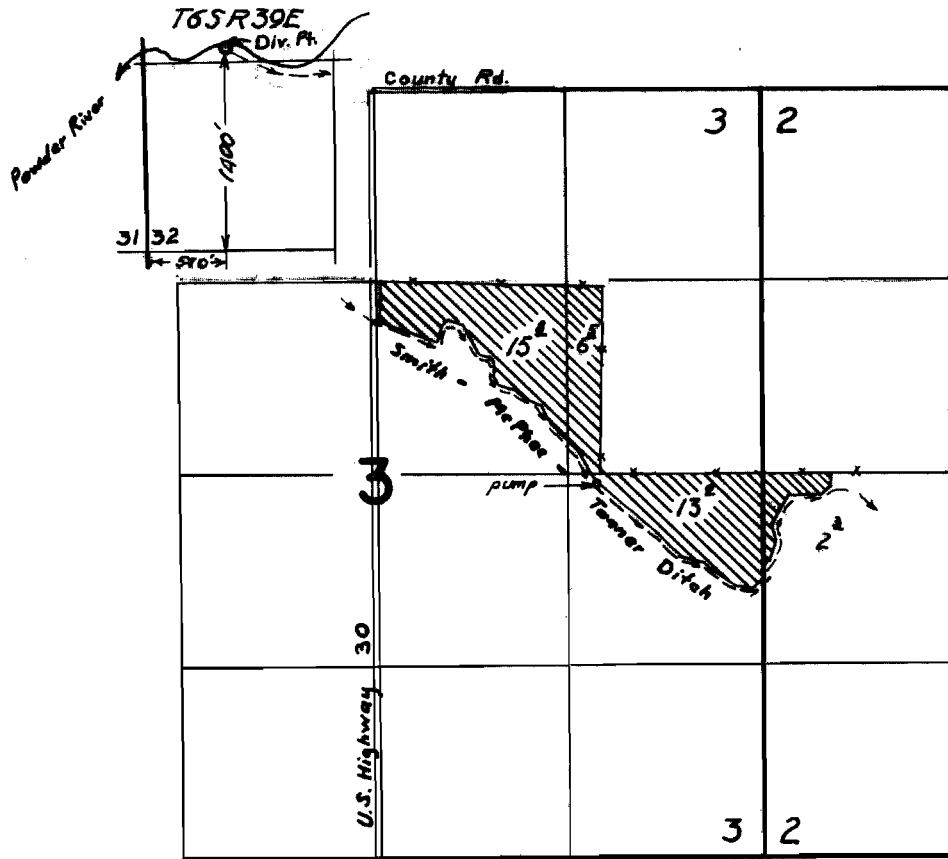

FINAL PROOF SURVEY UNDER

Application No. 40653 Permit No. 30456
IN NAME OF

GEORGE GEILS

Surveyed Oct. 23 1969, by L. E. Gould