


T. 14 S. R. 4 W. W.M.

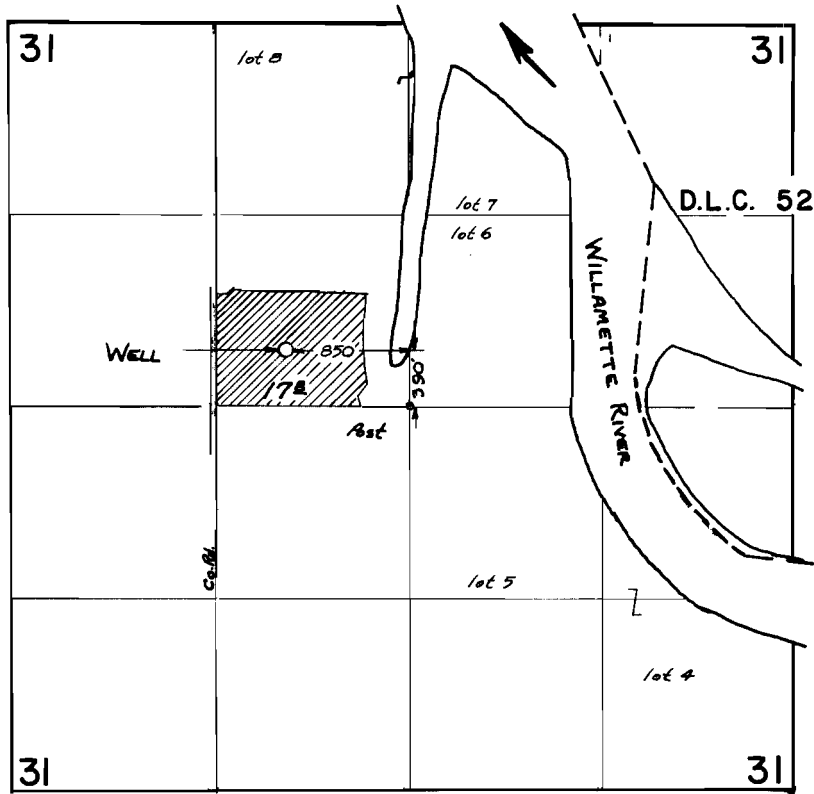

**FINAL PROOF SURVEY**  
UNDER

Application No. G 2604... Permit No. G 2408...  
IN NAME OF

**ANNIE WALDEN ESTATE**

Surveyed 24 MAR. 1970., by L.E. GOULD