


T.12S.R.5W.W.M.

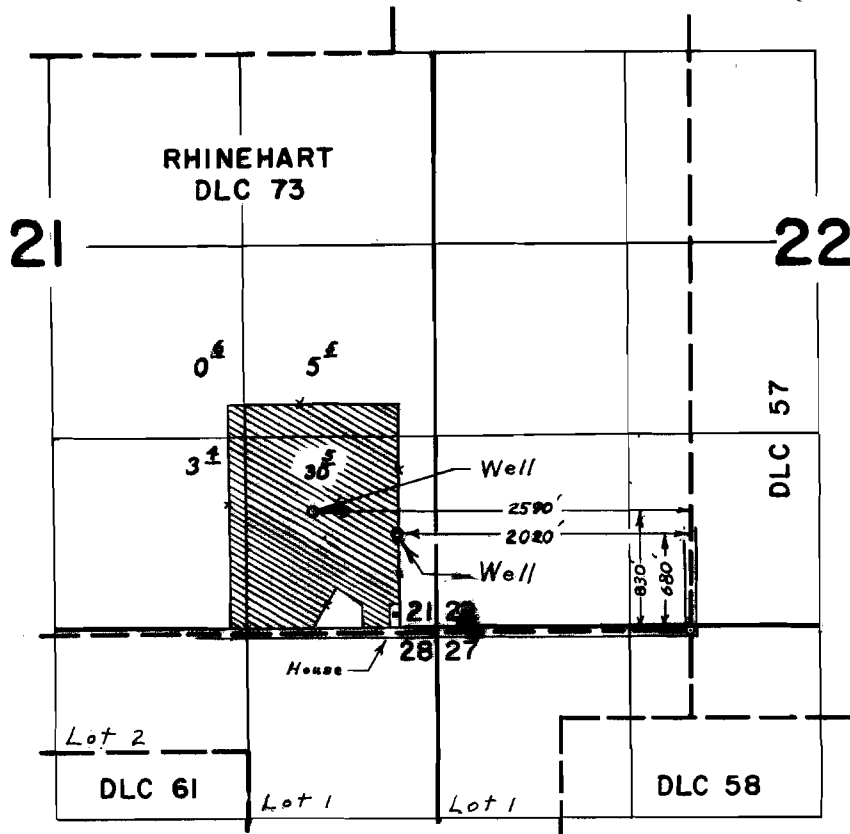

FINAL PROOF SURVEY
UNDER

Application No. G-3265 Permit No. G-3062
IN NAME OF

C. A. MINTY

Surveyed Jul. 2 1969, by L. E. Gould