


T.13S.R.7W.W.M.

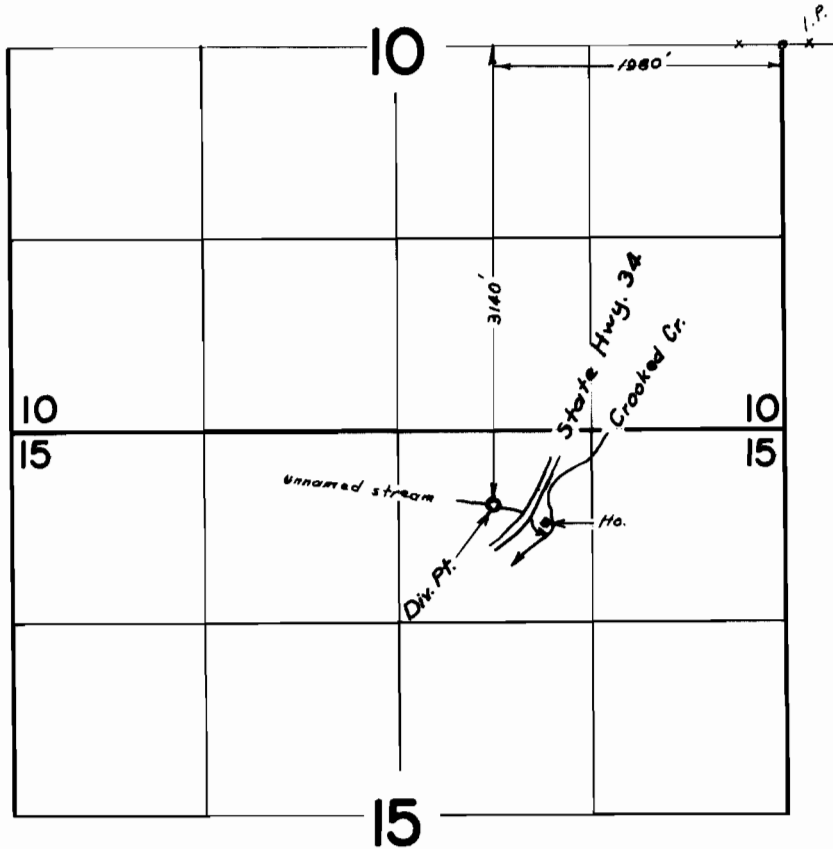

**FINAL PROOF SURVEY**  
UNDER

Application No. 39017 Permit No. 29062  
IN NAME OF

**MR. & MRS. FRANK M. MORRIS**

Surveyed Nov. 14, 1969, by L. E. Gould